


Gidw.

PROJECT Phase II SHEET _____ OF _____

SUBJECT _____ DATE 3-9-18

JOB NO. 4447

BY Atlas

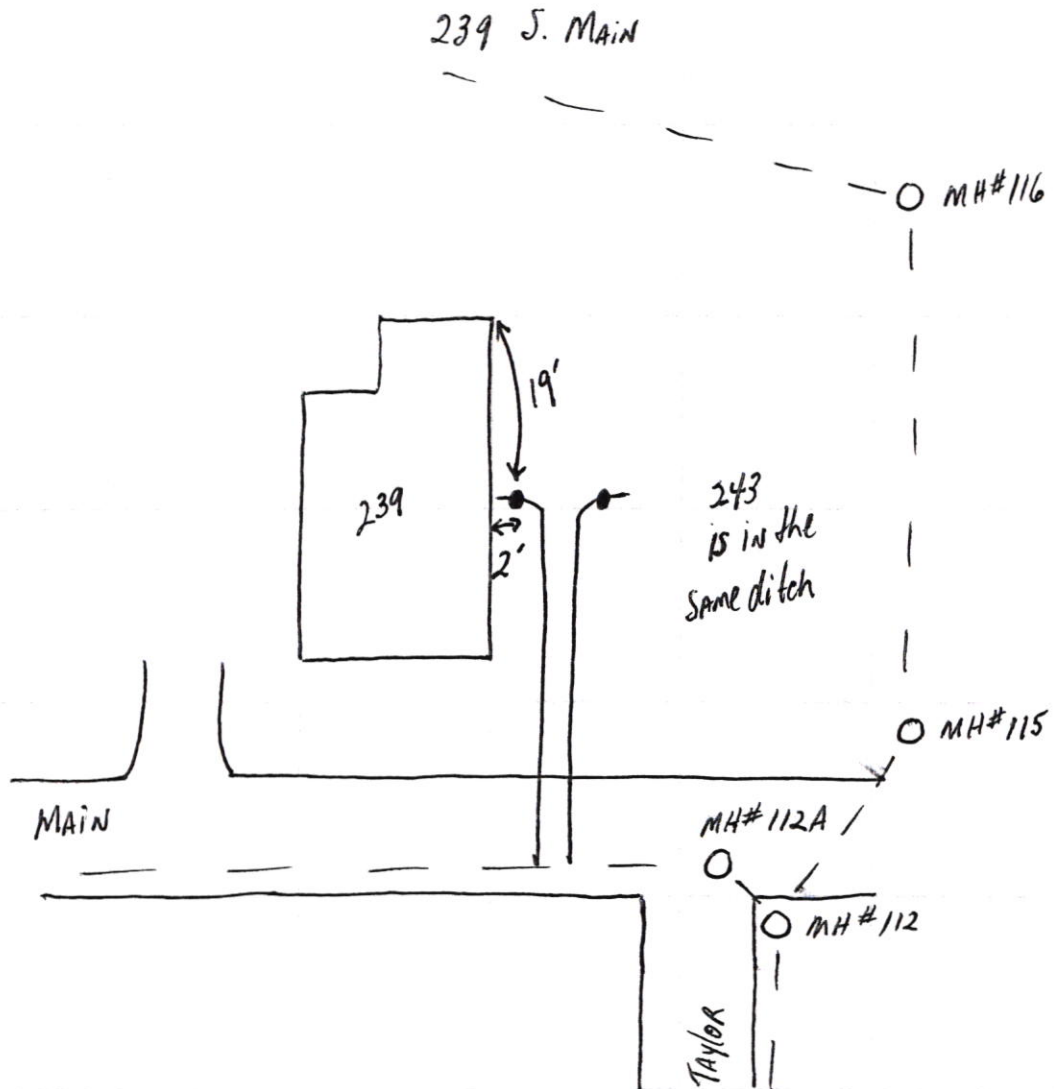

239 S Main

SHP
Phase II

4.24.18

