

Side

PROJECT Phase II

SHEET _____ OF _____

SUBJECT _____


DATE 7-16-15 1-15-19

JOB NO. 4447


BY Atlas

240 S. Pearl

← N

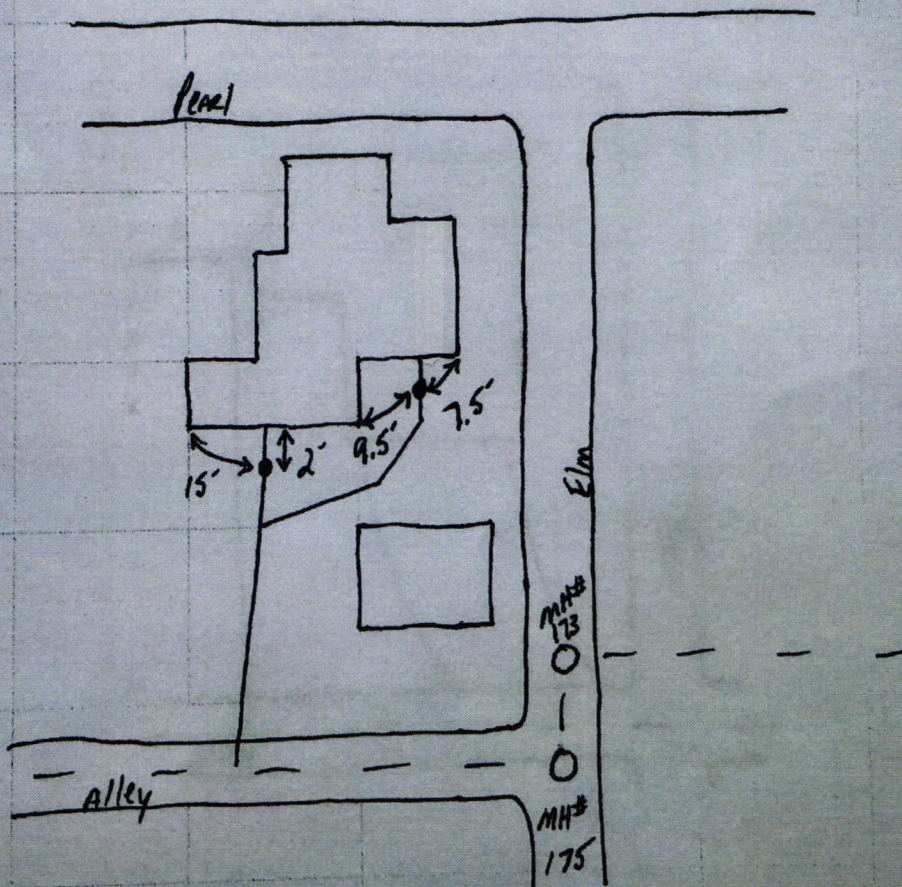


210 S Pearl St

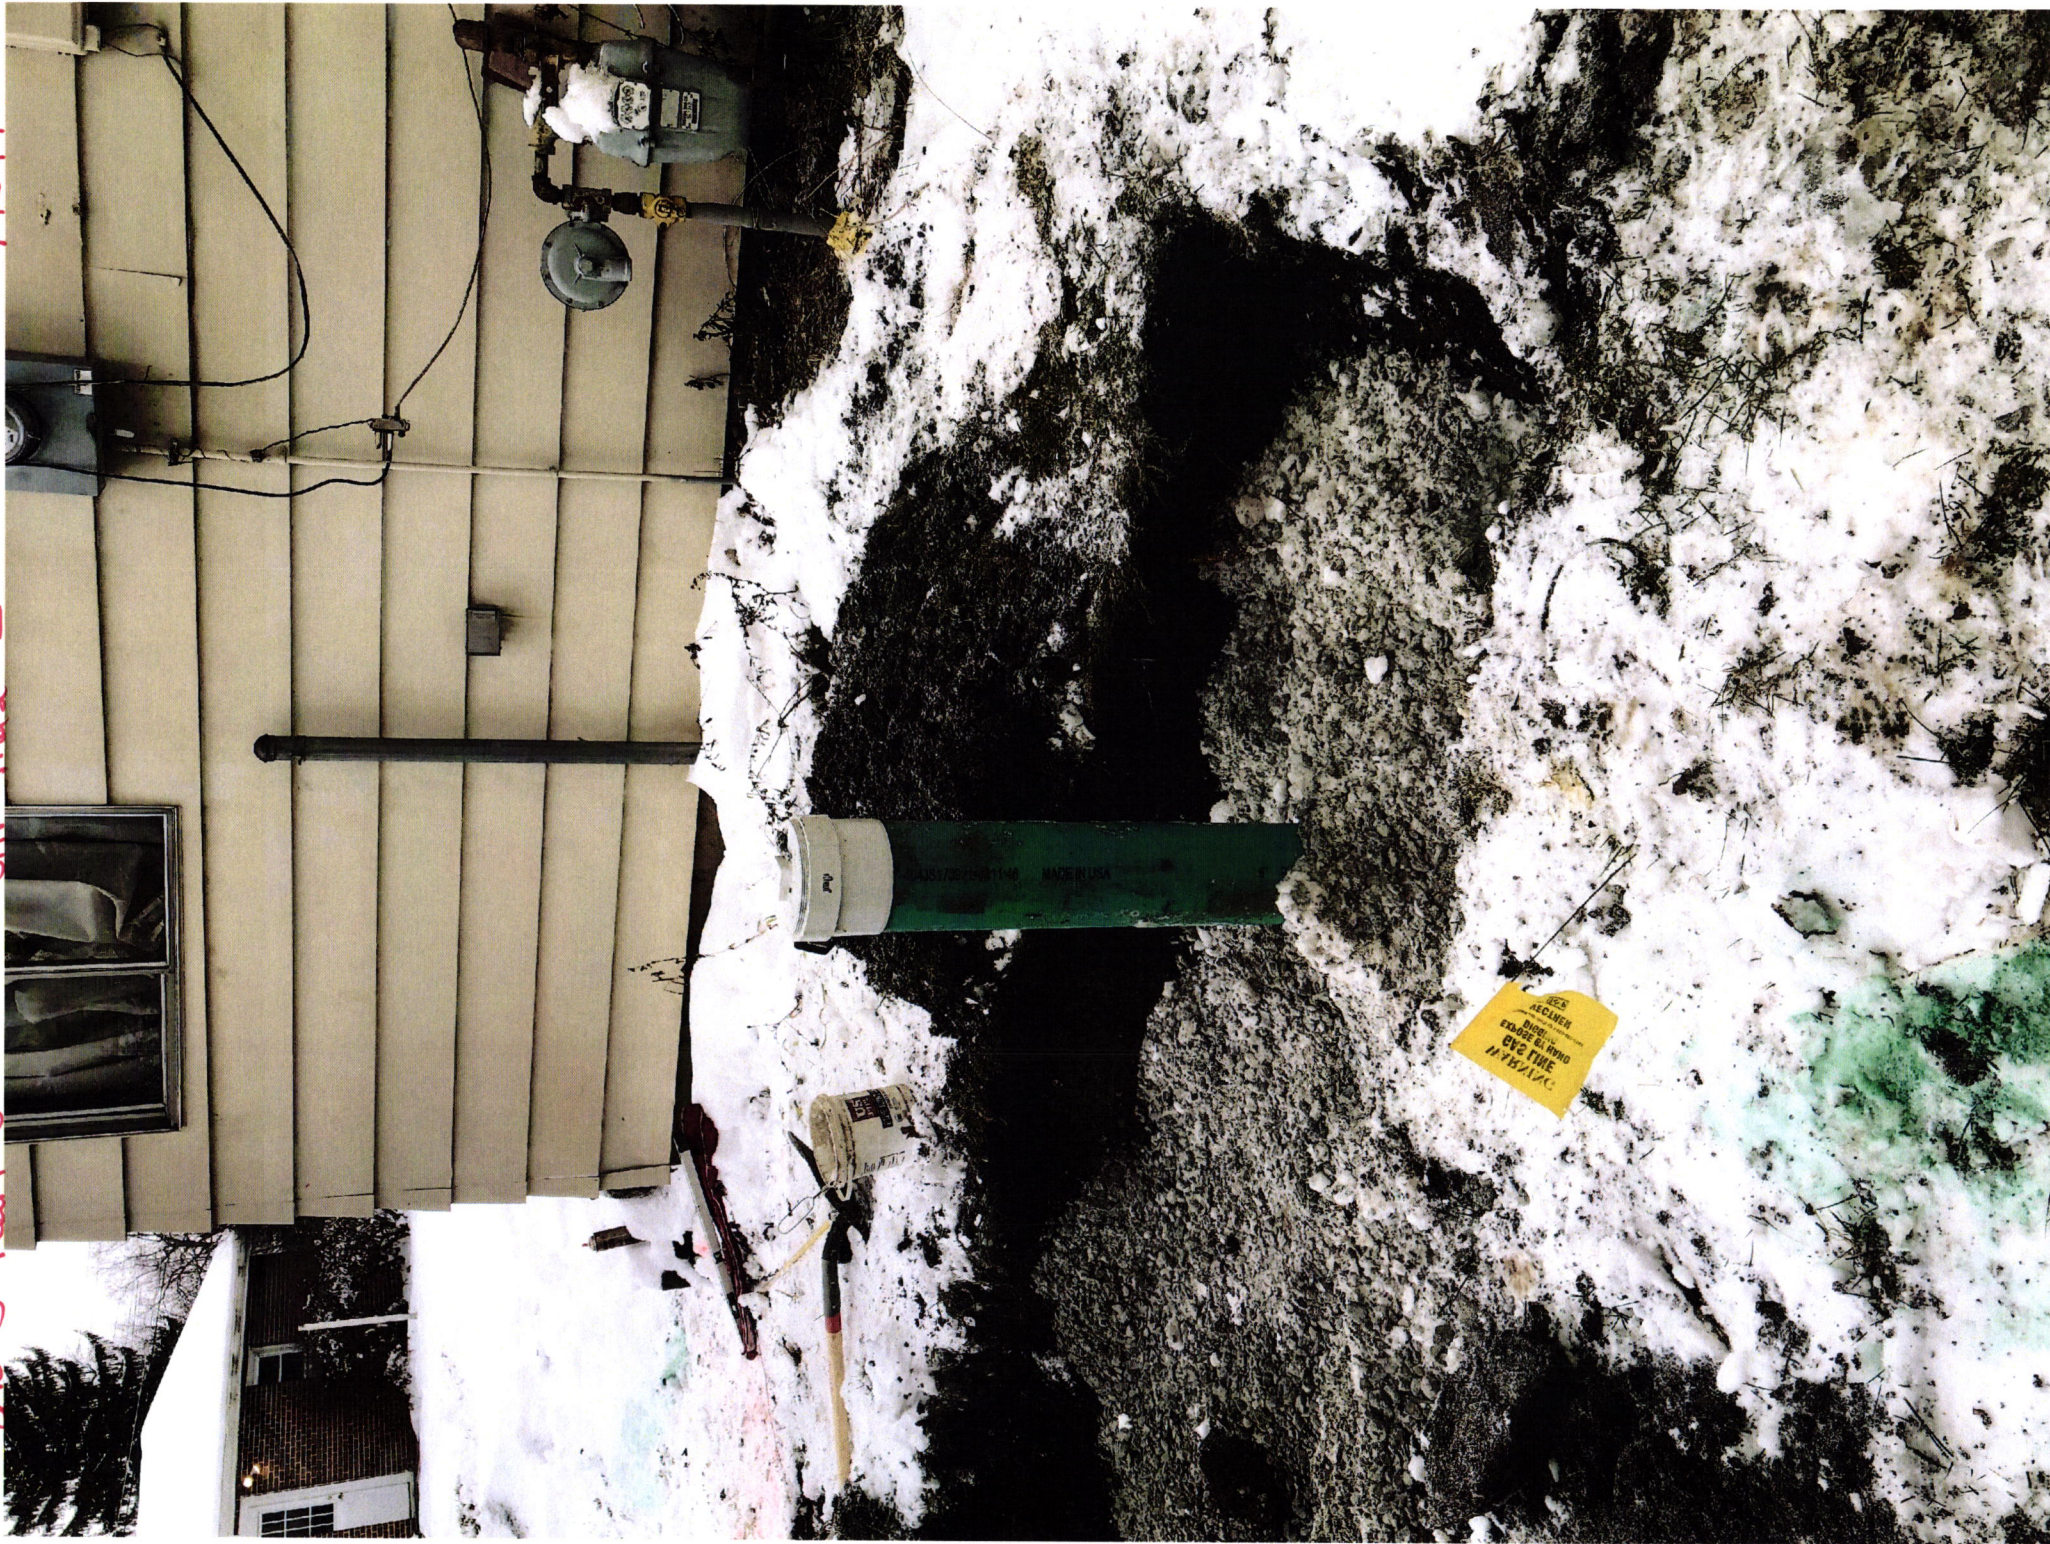

Gidw.

PROJECT Phase II SHEET _____ OF _____
SUBJECT _____ DATE 7-16-15
JOB NO. 4447
BY Atlas

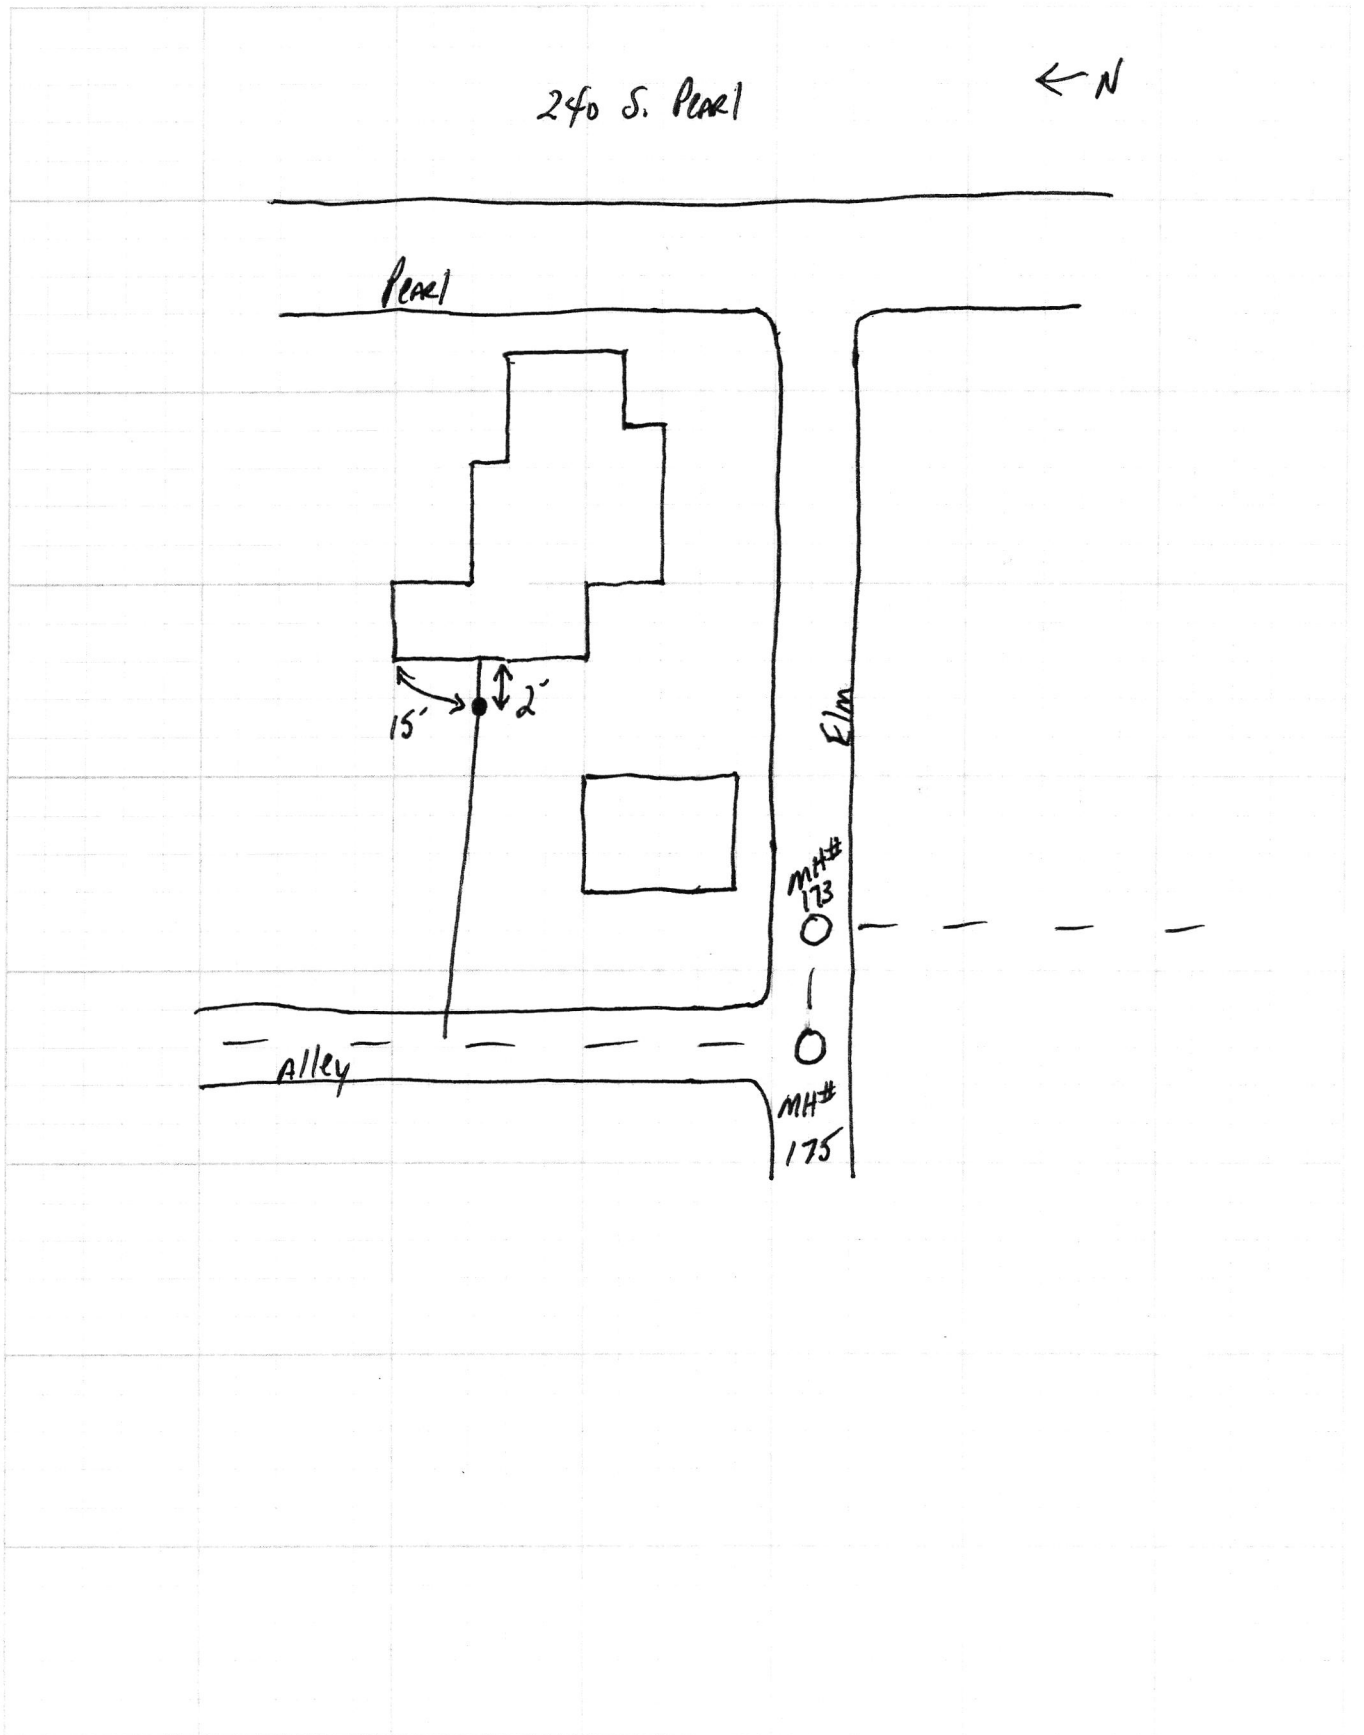

240 Pearl

SPT Phase II

7.18.18

