

G.R.W.

PROJECT Phase II

SHEET _____ OF _____


SUBJECT _____

DATE 12-14-17

JOB NO. 4447

BY A4/AS

240 S. Pendleton

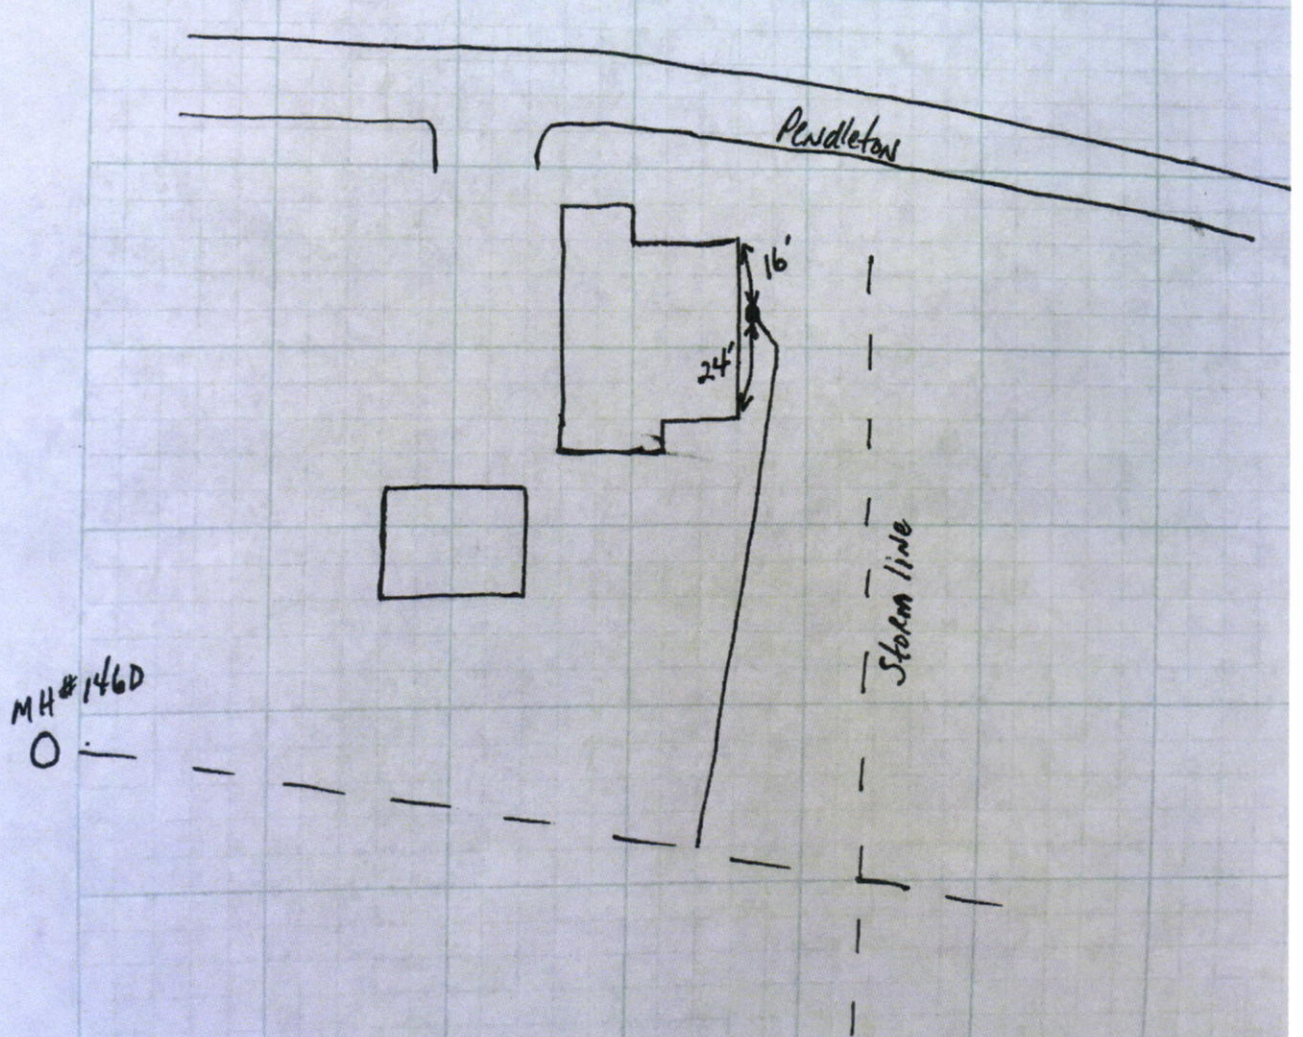

240 S Rendleton Ave Lateral Replacement

SRF Phase II
Dec '17

