


Gidw.

PROJECT PHASE II SHEET _____ OF _____
SUBJECT _____ DATE 6-29-18
JOB NO. 4447
BY ATLAS

241 PEARL ST.

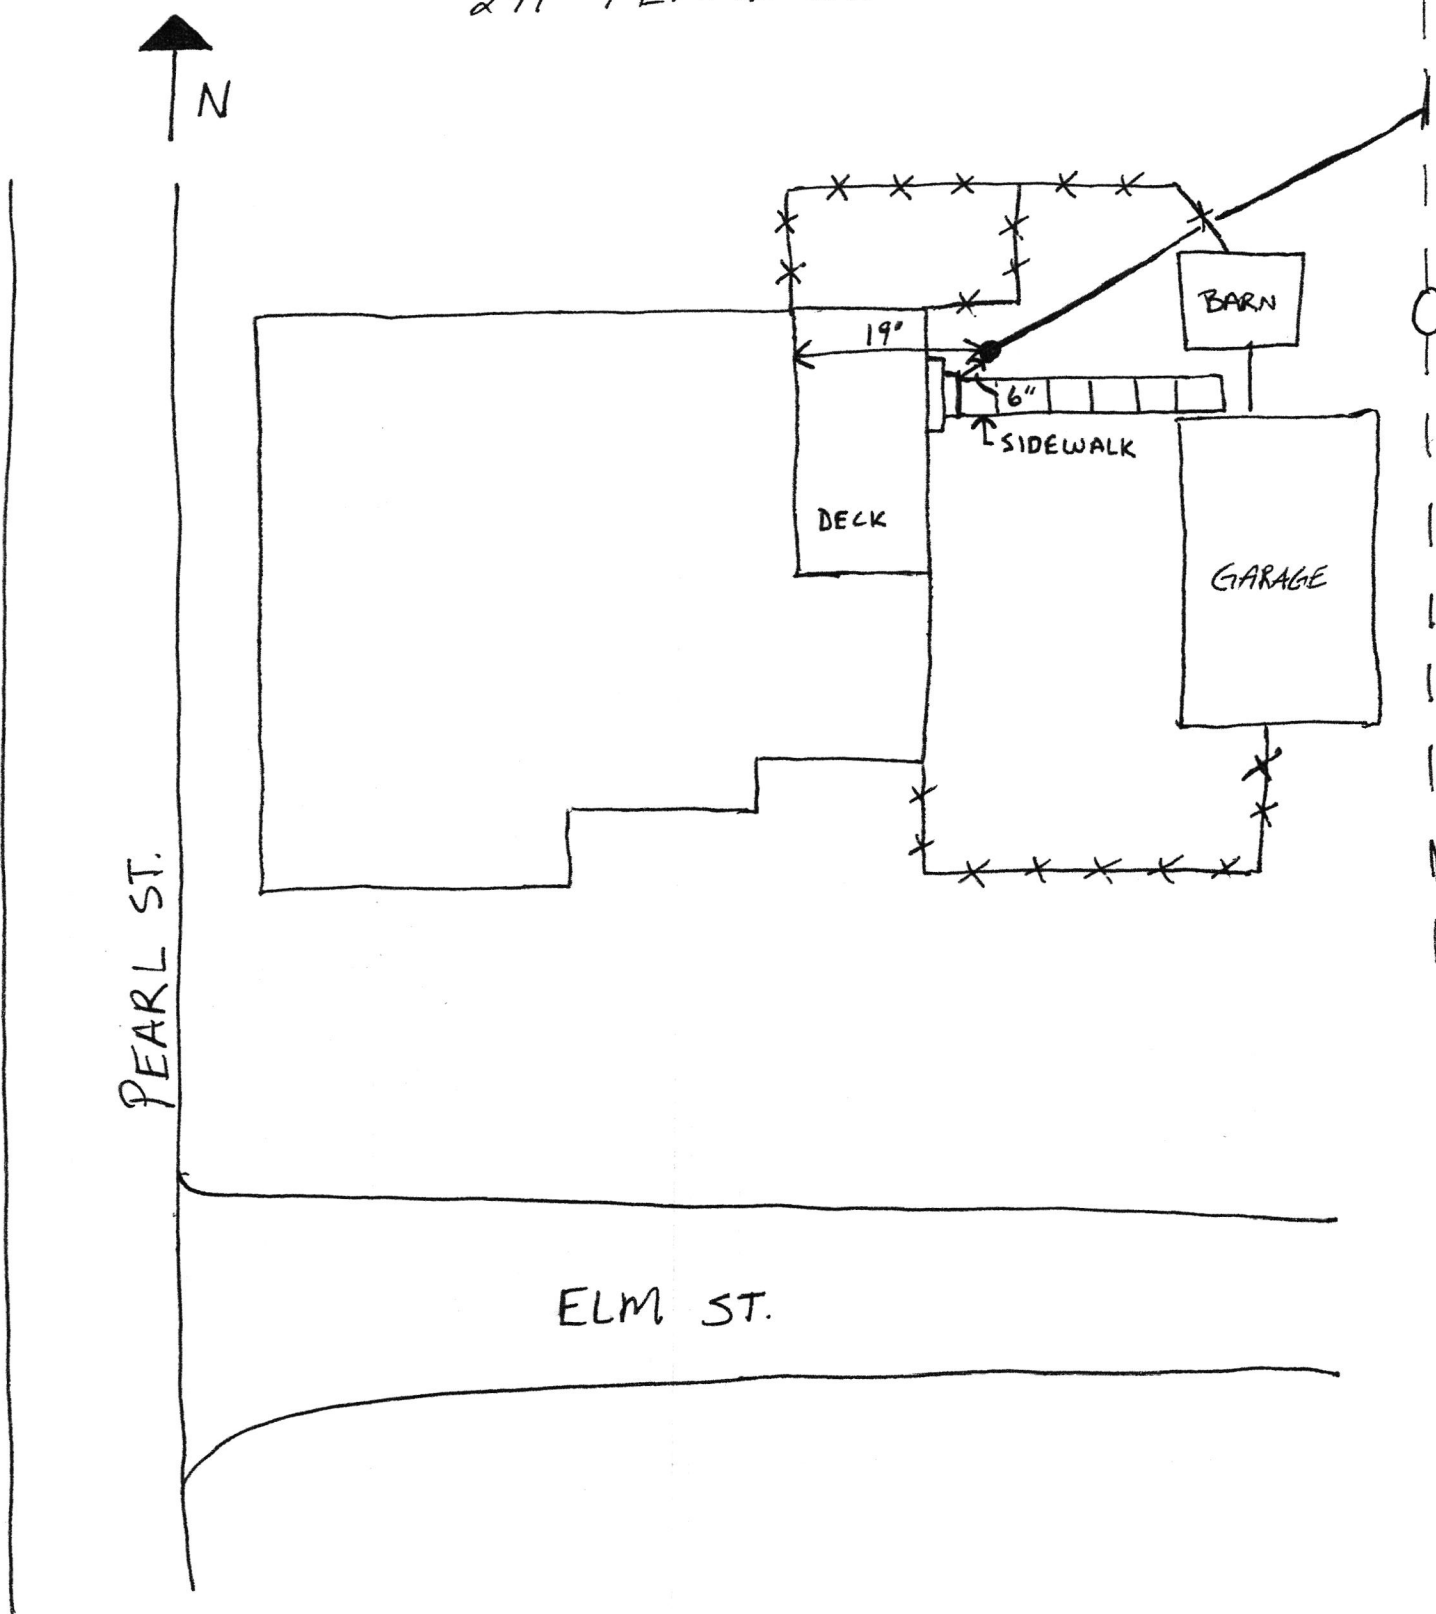

241 Pear-1

SPP Phase II

7.6.18

