




241 S Broadway

S&P Phase II

7.18.18

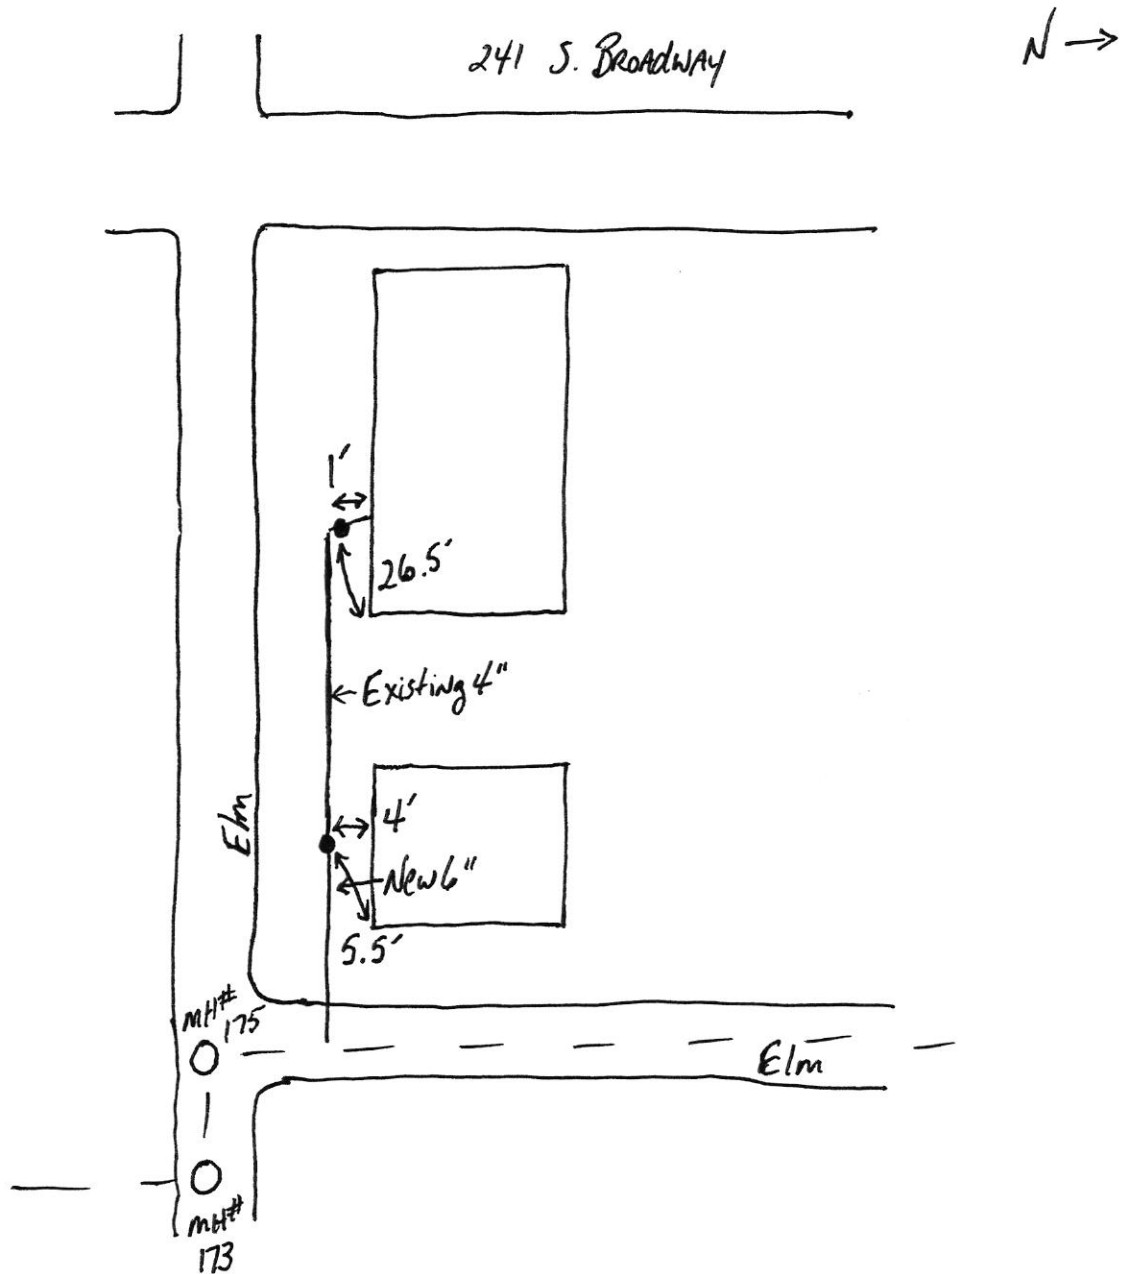