

Gidw.

PROJECT PHASE II

SHEET _____ OF _____


SUBJECT _____

DATE 7-2-18

JOB NO. 4447

BY ATLAS

242 S. EAST ST.

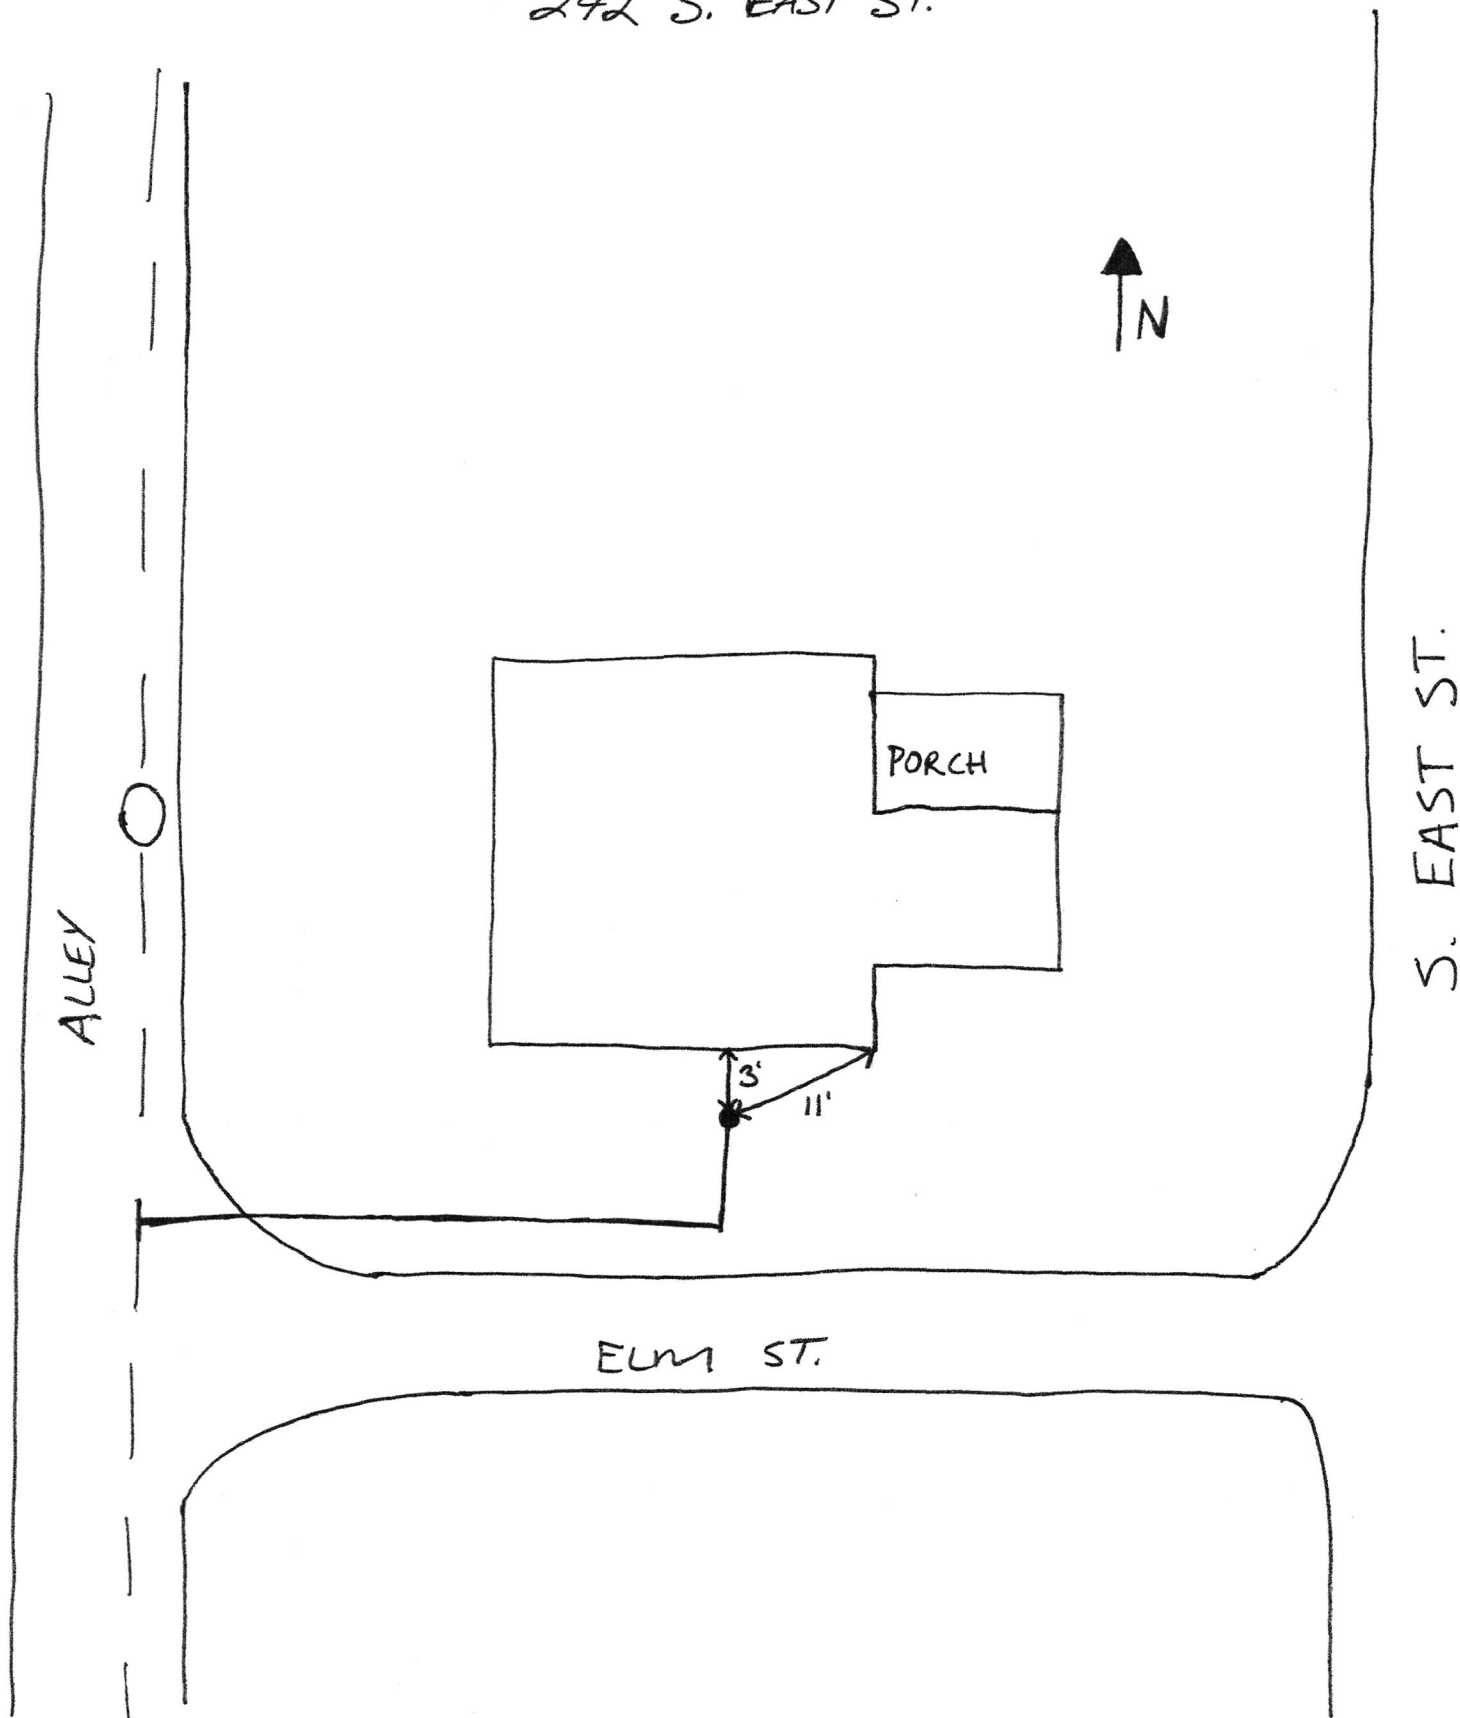

24a East

Spr Phase II

7.6.18

