


PROJECT Phase II SHEET _____ OF _____
SUBJECT _____ DATE 2-16-18
JOB NO. 4447
BY Atlas

242 S. Adams / 502 W. Taylor

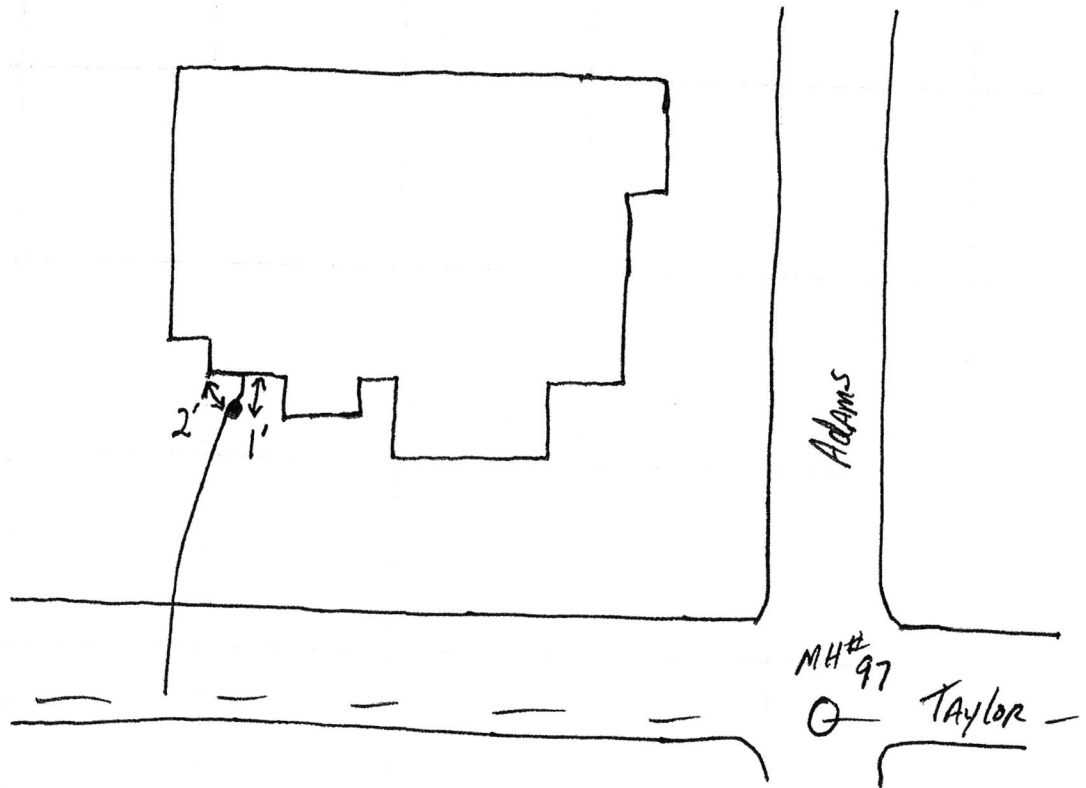

242 S Adams
(502 w Taylor)

SRF Phase II

2018

