


G.R.

PROJECT Phase II SHEET _____ OF _____
SUBJECT _____ DATE 2-7-18
JOB NO 4447
BY At/As

242 S. MAIN

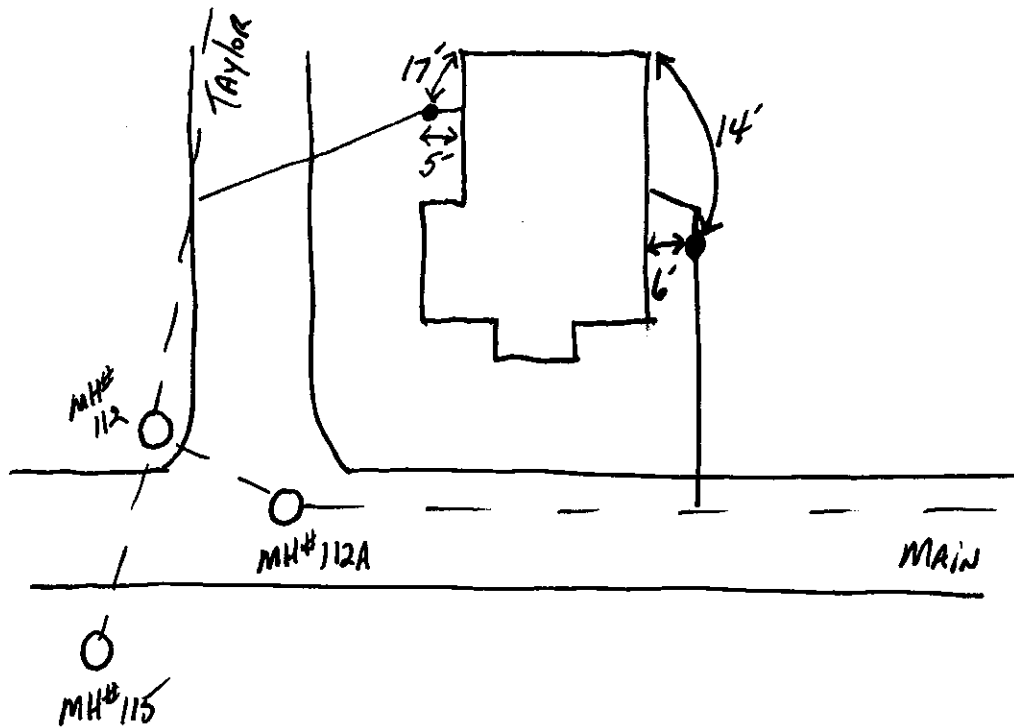

242 S main

SRF Phase II

2.7.18



242 S main

SRF Phase II

2.7.18

