

Gidw.

PROJECT Phase II


SHEET _____ OF _____

SUBJECT _____

DATE 3-7-18

JOB NO. 4447

BY Atlas

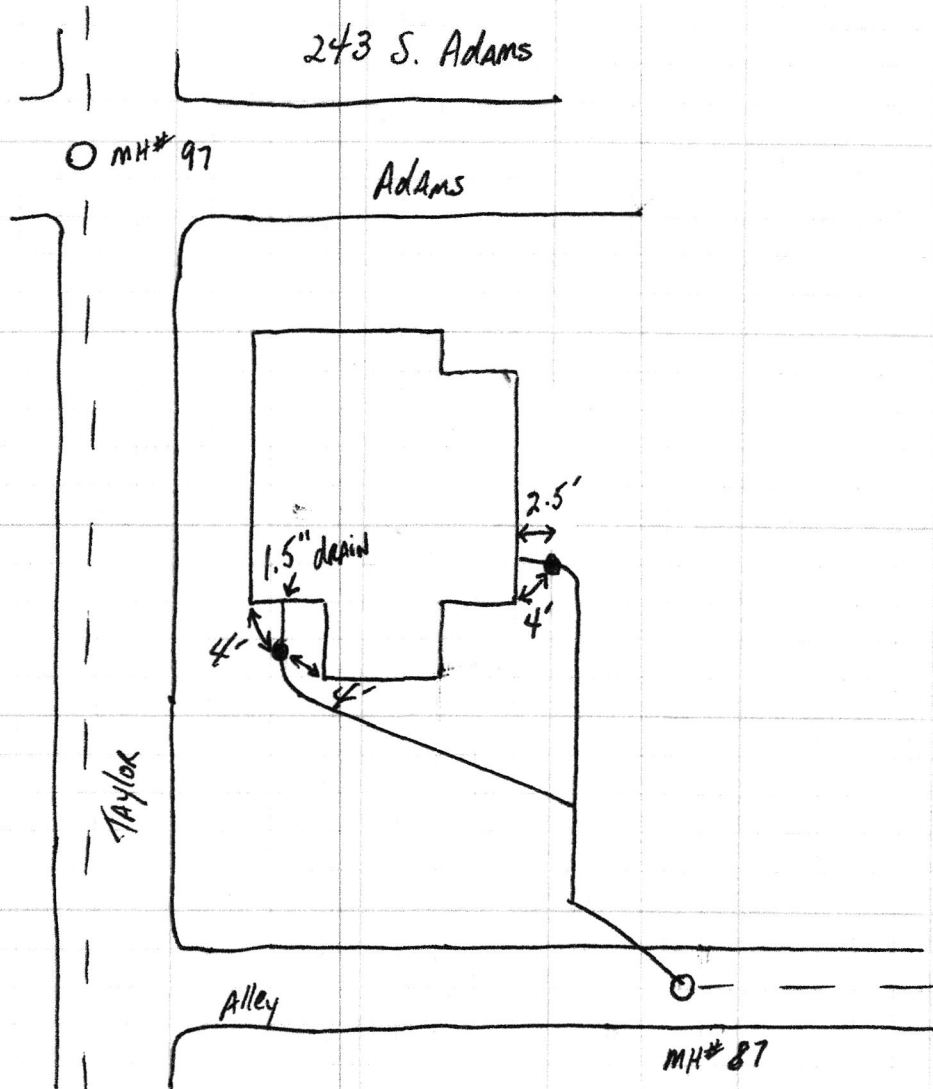

243 S Adams

SRP Phase II



243 S Adams

SRP Phase II

