

Gidw.

PROJECT Phase II


SHEET _____ OF _____

SUBJECT _____

DATE 3-12-18

JOB NO. 4447

BY Atlas

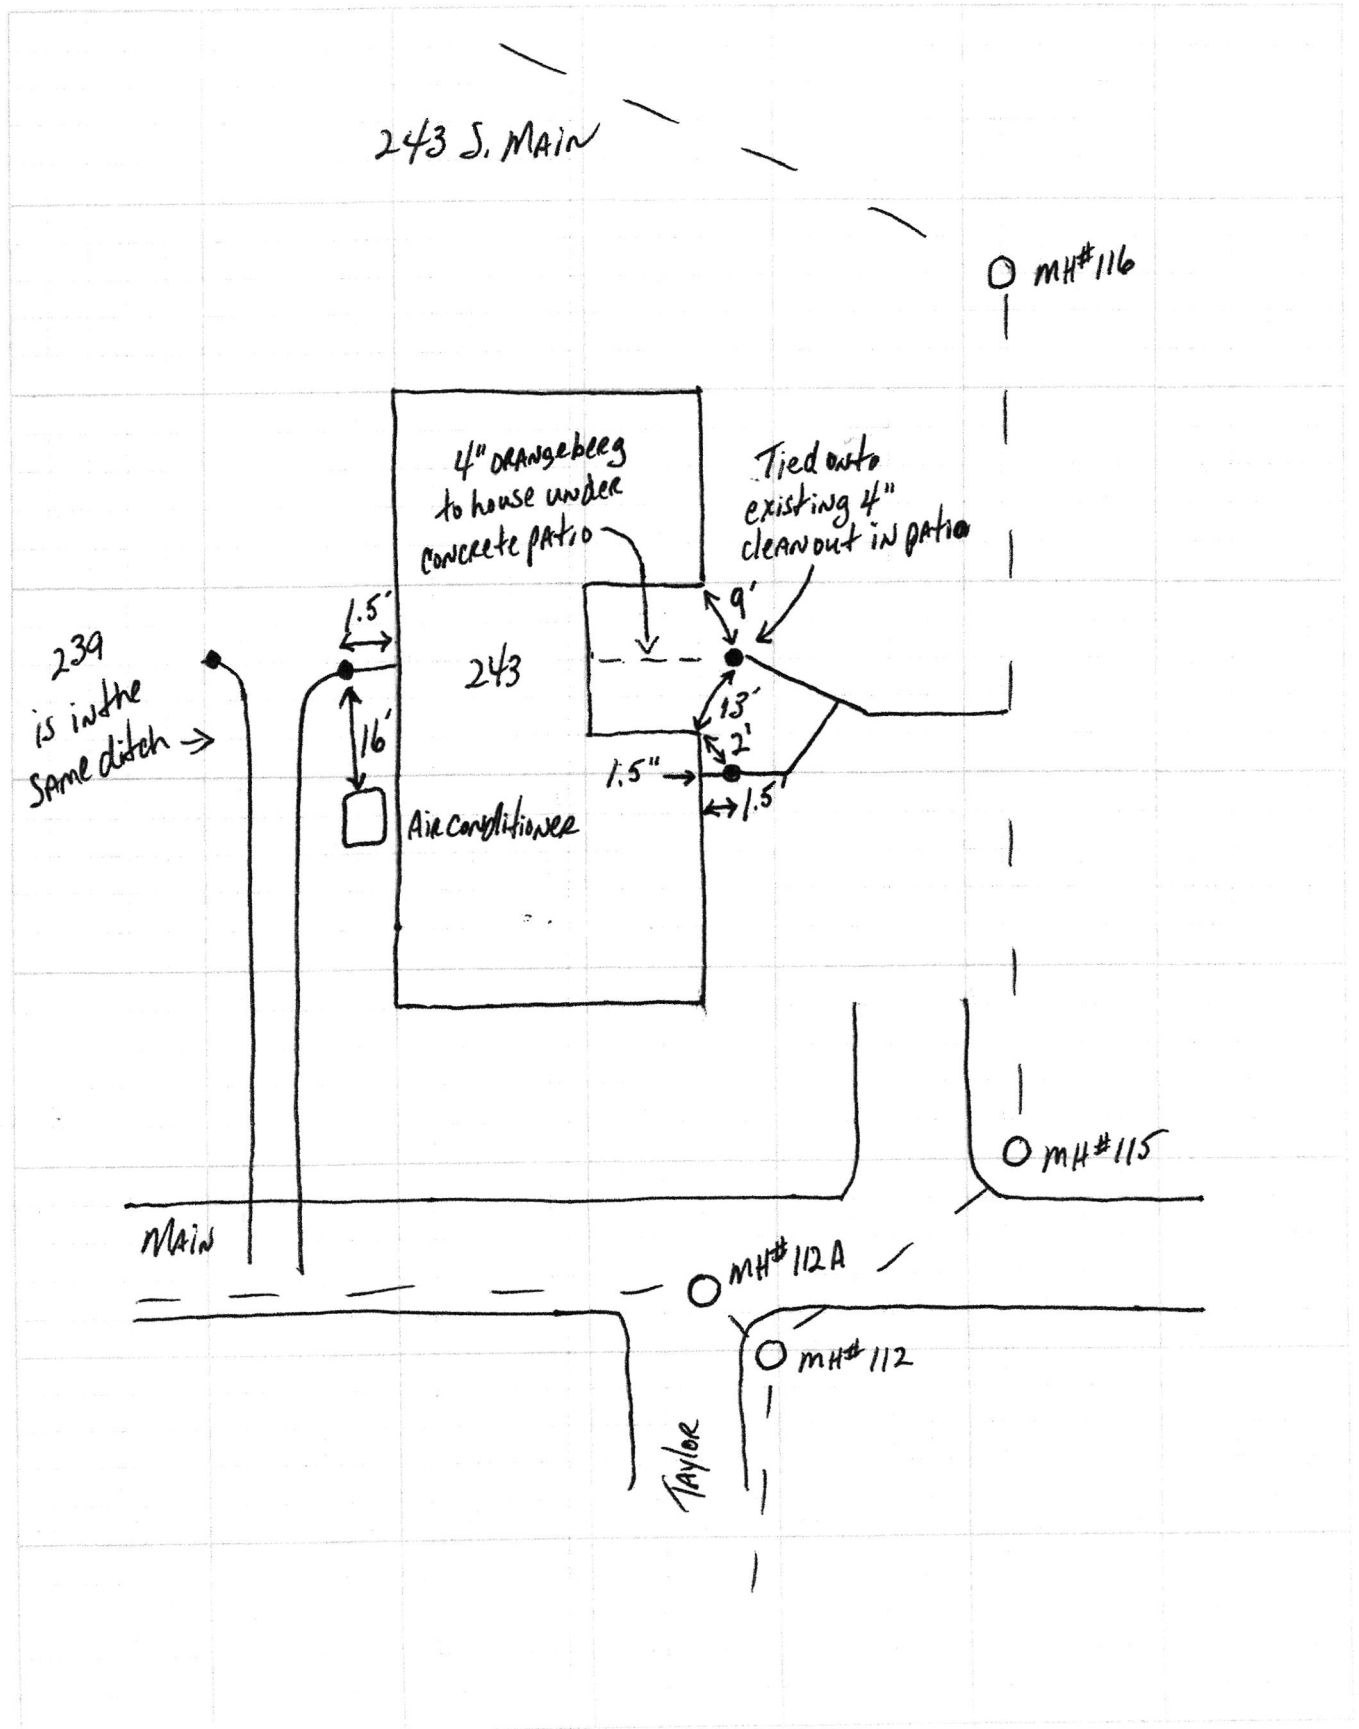

243 S main

SRR Phase II



243 S main

SRP Phase II

