

G.R.W.


PROJECT Phase II SHEET _____ OF _____

SUBJECT _____ DATE 4-13-18

JOB NO. 4447

BY Atlas

243 S. West

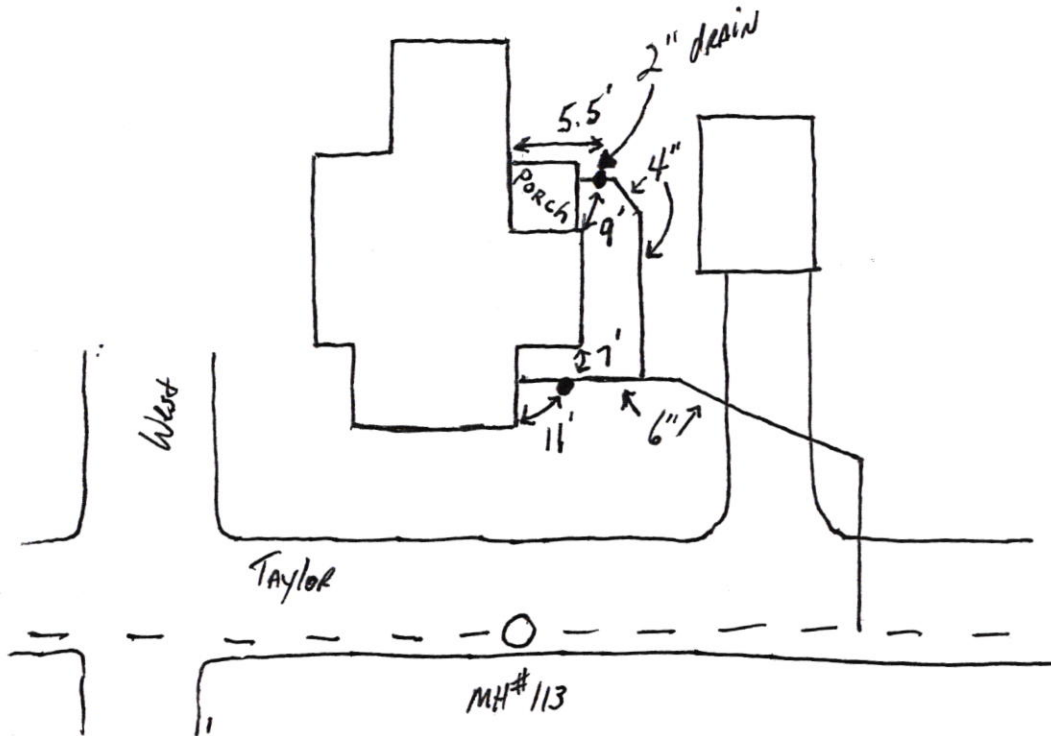

243 S West

SRP
Phase II

4.20.18



243 S West

SRP
Phase II

4.20.18

