


GRW

PROJECT Phase II SHEET _____ OF _____
SUBJECT _____ DATE 2-13-18
JOB NO. 4447
BY Atlas

244 Franklin St.

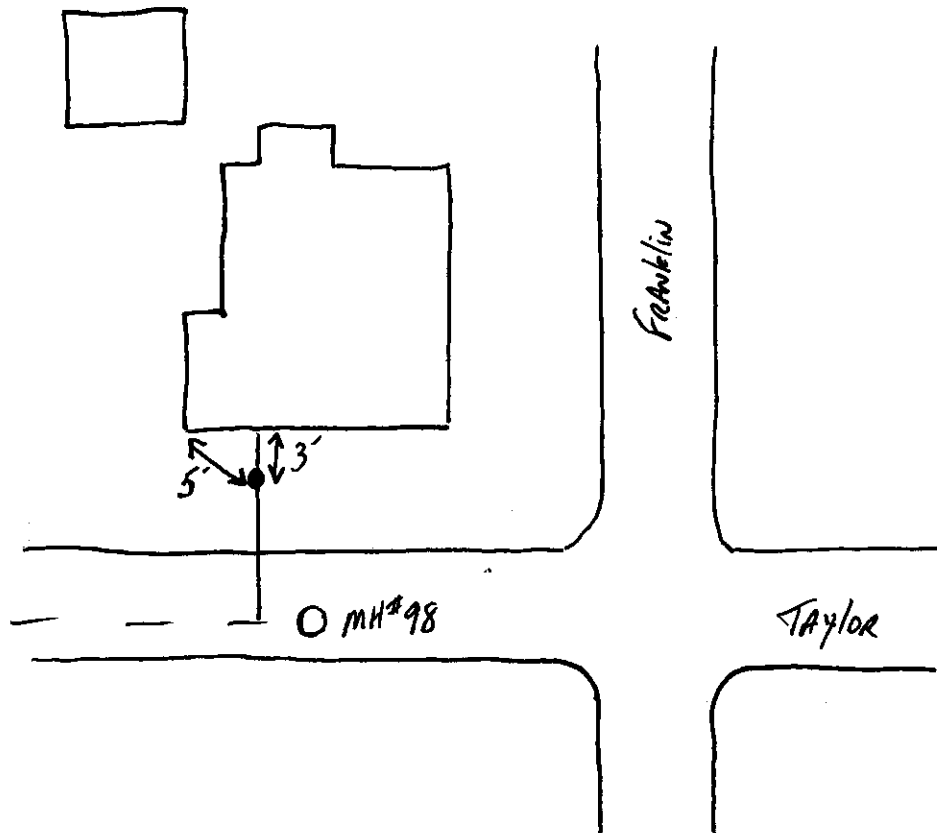

244 Franklin

SRF Phase II

2.13.18

