



FALL CREEK REGIONAL WASTE DISTRICT

Box 44, Pendleton, Indiana 46064

3-0919618

Nº 000053

APPLICATION FOR SEWER PERMIT

Permit No. _____ Date 7-31-85
 Permit Void 90 days from Date of Issuance
 Owner Name Worlie Jones
 Property Address R2 Box 37A 245 St. Garden
 Lot # _____ P.O. Box _____
 Town PENDLETON, IN Zip Code 46064-9505
 Phone 778-2595 Water Meter no
 \$ 150⁰⁰ Tap on Fee Paid
 \$ 25⁰⁰ Inspection fee paid

Application is hereby made for connection to the Fall Creek Regional Waste District Sewer System for the above listed property - Permit Type: Residential ☒, Commercial _____, Industrial _____, or Governmental/Institutional _____. User Information _____.

All workmanship and materials shall conform to the standards of the District Ordinance as described in Ordinance 84-2 and 84-3 as amended. Acceptance and approval must be made by the District inspector or his duly authorized representative before backfilling and final connection is made to the main sewer lines. Any violation of applicable regulations will cause all lines and appurtenances in violation to be removed and replaced at the owners expense.

The Fall Creek Regional Waste District is responsible for the inspection, approval of materials, and installation techniques only. All costs for materials and installation and any liabilities resulting from same is the sole responsibility of the property owner.

I have read and fully understand the above provisions and agree to comply by said provisions.

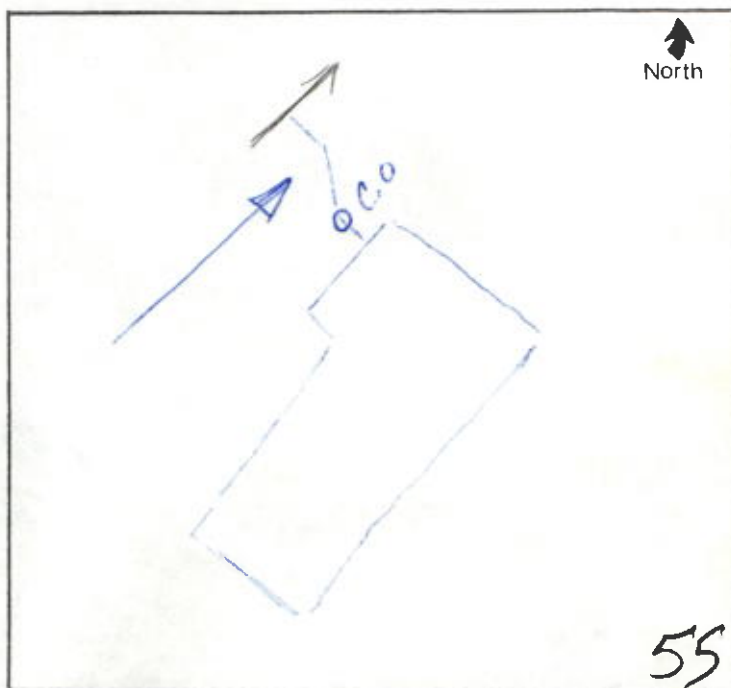
✓ Worlie Jones

APPLICANT(S) SIGNATURE

INSPECTOR

Doug (Ben)Date inspected 8/5/85 Approved _____ Rejected ☒Reason for rejection Improper Slope on pipe at Nipple & at Clean-out.Date reinspected 8-5-85 Approved ☒ Rejected _____

Notes:

Size Pipe 6"Type Pipe PVCBasement Yes _____ No ☒Sump Pump Yes _____ No ☒Downspout to Ground Yes ☒ No _____Septic Tank Pumped & filled Yes _____ No ☒Contractor JERRY COXSpecial Conditions Septic Tank UNDER POURED CEMENT PATIO

North

55