
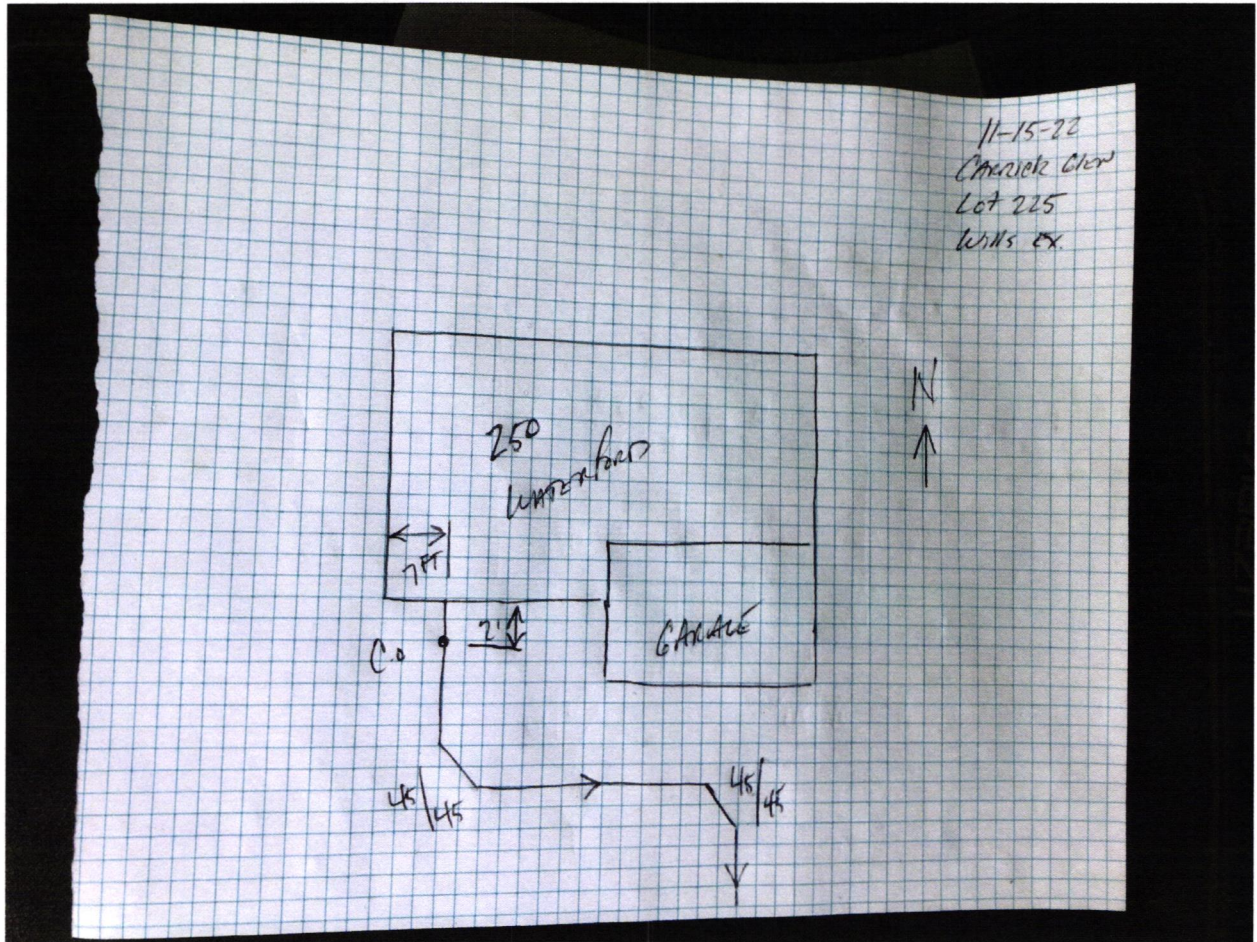


North 

Drawing
+
2 pictures
attached



250 Waterford CT ^{Ln}

Carrick Glen Lot 225

Donnie Moore 11/15/2022





B-H HORTON AMERICA'S BUILDER

DRH Inc. Controlled Disb
1341 Horton Circle
Arlington, TX 76011

JP Morgan Chase Bank, N.A.
Syracuse, NY

Check Number 1435385

50-937
213
2720128

Date	Amount
01/17/22	\$*****760.00
Void after 6 months from date of issue	

SEVEN HUNDRED SIXTY AND 00/100 *****

Pay To The Order Of:
FALL CREEK REGIONAL WASTE DISTRICT
9378 SOUTH 650 WEST
PENDLETON IN 46064

D.L. Horton

CG225

012047

COPY