

FALL CREEK REGIONAL WASTE DISTRICT

9378 S 650 WEST, P.O. BOX 59, PENDLETON, IN 46064

765-778-7544

AGREEMENT FOR SANITARY SEWER SERVICE

This Agreement made and entered into this 8th day of May, 2001, between FALL CREEK REGIONAL WASTE DISTRICT ("District") and Ken Schrader ("Applicant") regarding the provision of sanitary sewer service, and the assignment of capacity in, and connection to, the District's facilities for the premises located at 2517 W. Ridge Lane

NOW THEREFORE, the parties, in consideration of the mutual promises set out in this Agreement, the receipt and sufficiency of which is hereby acknowledged, agree as follows:

1. The Applicant agrees that all workmanship and materials shall conform to the District's construction standards. District must accept and approve all connection is made to the sewer mains. Any violation of this provision will result in the work to be removed and replaced at the Applicant's expense.
2. The District shall have the right to enter upon the Applicant's property to inspect, repair, or replace any equipment used in connection with the District's sanitary sewer service.
3. The Applicant shall be responsible for all monthly user rates, capacity charges, and tap fees. The failure to pay any rate charge or fee may result in a lien against the property and/or the termination of service to the property, the cost of which will be borne by Applicant, including, but not limited to, all attorney's fees and collection costs.
4. The District shall not be responsible for any damages as a result of any failure to supply service unless said damages are due to default, neglect or culpability on the part of the District.
5. If there is an available sanitary sewer within three hundred (300) feet of the property line, the property owner shall be required to connect to the District's sanitary sewer system.
6. The Applicant and District agree that the provision of sanitary sewer service touches and concerns the property and the terms of this Agreement bind the District and Applicant and their heirs, executors, administrators, personal representatives, successors, agents, attorneys, assigns, designees, and transferees.

The parties hereto have read and fully understand the above provisions and agree to comply with said provisions.

FALL CREEK REGIONAL WASTE DISTRICT

Signature Jan Carey

APPLICANT

Signature Ken Schrader

STATE OF INDIANA)

) SS:

COUNTY OF MADISON)

SUBSCRIBED and sworn to before me this 8th day of May, 2001.

My Commission Expires:

2-20-2008

Signature

Deborah L. Wilson

Printed

Deborah L. Wilson

Notary Public

Resident of Madison County

INSPECTOR Tim DATE INSPECTED 7-30-01 APPROVED ✓ REJECTED _____

REASON FOR REJECTION _____

DATE REINSPECTED _____ APPROVED _____ REJECTED _____

NOTES:

SIZE PIPE 6" TYPE PIPE SDR35

BASEMENT YES ✓ NO _____

SUMP PUMP YES _____ NO ✓

DOWNSPOUT TO GROUND YES ✓ NO _____


SEPTIC TANK PUMPED & FILLED YES ✓ NO _____

CONTRACTOR Fredricks

SPECIAL CONDITIONS _____

EXISTING HOME ✓

NEW CONSTRUCTION _____

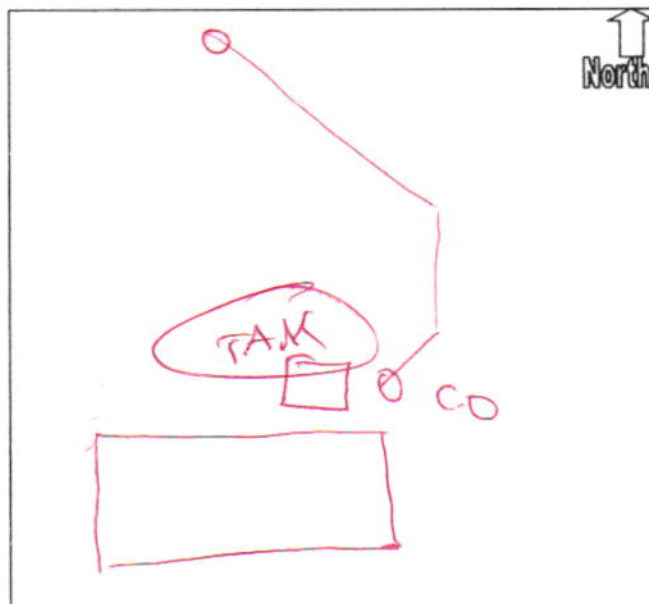

add order on file

4361

26-04150.01

Put in
Bens Jimis
mailbox
7-30-01

KENNETH C. SCHRADER
AGNES J. SCHRADER
2517 RIDGE LANE
ANDERSON, IN 46013

NATIONAL CITY BANK OF INDIANA
ANDERSON, IN 46016
20-6/740

5679

May 8, 2001

PAY TO THE
ORDER OF

Fall Creek Regional Waste District
Four hundred and 00/100

\$ 400.00

DOLLARS

Security features
included.
Details on back.

MEMO

sewer tap fee

⑈005679⑈ ⑆074000065⑆

Kenneth C. Schrader