

add order)  
on file

4259

26-4550.00

## AGREEMENT FOR SANITARY SEWER SERVICE

This Agreement made and entered into this 16<sup>th</sup> day of April, 2001, between FALL CREEK REGIONAL WASTE DISTRICT ("District") and Brian Robbins ("Applicant") regarding the provision of sanitary sewer service, and the assignment of capacity in, and connection to, the District's facilities for the premises located at 2547 Woodlawn.

Check  
w/Donnie  
on this one

1. The Applicant agrees that all workmanship and materials shall conform to the District's construction standards. District must accept and approve all work and connection is made to the sewer mains. Any violation of this provision will cause all to be removed and replaced at the Applicant's expense.
2. The District shall have the right to enter upon the Applicant's premises at all reasonable times to inspect, repair, or replace any equipment used in connection with the District's service or which has an impact on said service.
3. The Applicant shall be responsible for all monthly user rates, capacity charges, and tap fees. The failure to pay any rate charge or fee may result in a lien against the property and/or the termination of service to the property, the cost of which will be borne by Applicant, including, but not limited to, all attorney's fees and collection costs.
4. The District shall not be responsible for any damages as a result of any failure to supply service unless said damages are due to default, neglect or culpability on the part of the District.
5. If there is an available sanitary sewer within three hundred (300) feet of the property line, the property owner shall be required to connect to the District's sanitary sewer system.
6. The Applicant and District agree that the provision of sanitary sewer service touches and concerns the property and the terms of this Agreement bind the District and Applicant and their heirs, executors, administrators, personal representatives, successors, agents, attorneys, assigns, designees, and transferees.

The parties hereto have read and fully understand the above provisions and agree to comply with said provisions.

FALL CREEK REGIONAL WASTE DISTRICT  
*John E. Carey*  
 Signature

APPLICANT  
Frank Robinson  
Signature

STATE OF INDIANA )  
 ) SS:  
COUNTY OF MADISON)

SUBSCRIBED and sworn to before me this \_\_\_\_\_ day of \_\_\_\_\_, 200\_\_\_\_\_.

My Commission Expires:

Signature \_\_\_\_\_

Printed \_\_\_\_\_

Notary Public  
Resident of Madison County

\*\*\*\*\*  
INSPECTOR Don DATE INSPECTED 4/2/01 APPROVED ✓ REJECTED       

REASON FOR REJECTION \_\_\_\_\_

DATE REINSPECTED \_\_\_\_\_ APPROVED \_\_\_\_\_ REJECTED \_\_\_\_\_

NOTES: SIZE PIPE 6" TYPE PIPE 26

BASEMENT YES \_\_\_\_\_ NO ☒

SUMP PUMP YES ☐ NO ☒

DOWNSPOUT TO GROUND YES ☒ NO


SEPTIC TANK PUMPED & FILLED YES ☒ NO ☐

CONTRACTOR Kow Hing Kee

SPECIAL CONDITIONS FIVE (5) YEARS

EXISTING HOME ✓

NEW CONSTRUCTION

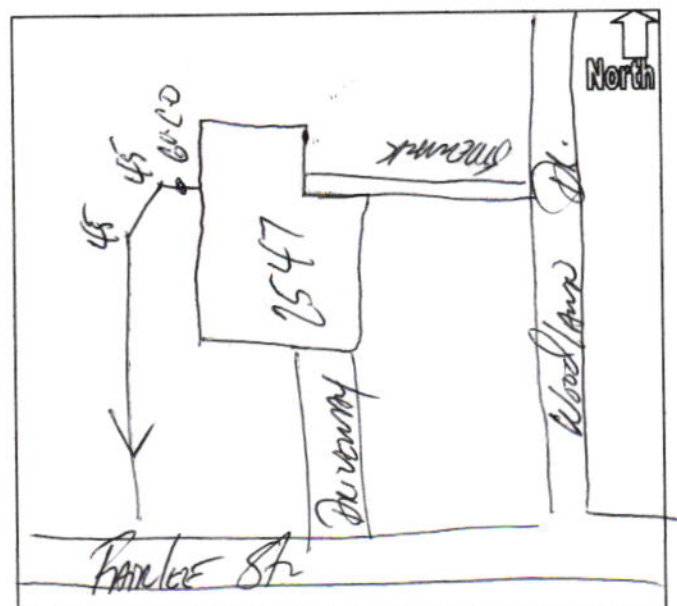

3102

Brian R. Robbins 4-82  
202 S Main St Ph 778-8088  
Pendleton, IN 46064

4-16-01 DATE

71-553/749  
BRANCH 0PAY TO THE  
ORDER OF

Fan Creek Regional Waste

\$ 1,872.<sup>25</sup>Eighteen Hundred Seventy Two and <sup>25</sup>/<sub>100</sub>

DOLLARS

Security  
Features  
Details on  
BackMadison  
Community Bank

FOR

Tap/Capacity Fee

Brian R. Robbins

MP

⑆074905539⑆

02

© HARLAND