

Contractor: Ted's Plumbing

26-03400.00

FALL CREEK REGIONAL WASTE DISTRICT

4086

9378 S 650 WEST, P.O. BOX 59, PENDLETON, IN 46064

765-778-7544

AGREEMENT FOR SANITARY SEWER SERVICE

This Agreement made and entered into this 7th day of March, 2001, between FALL CREEK REGIONAL WASTE DISTRICT ("District") and Paul E Stephens ("Applicant") regarding the provision of sanitary sewer service, and the assignment of capacity in, and connection to, the District's facilities for the premises located at 2559 Tod Lane.

NOW THEREFORE, the parties, in consideration of the mutual promise and agreement, the receipt and sufficiency of which is hereby acknowledged, agree as follows:

1. The Applicant agrees that all workmanship and materials shall conform to the District's construction standards. District must accept and approve all work before connection is made to the sewer mains. Any violation of this provision will result in the work to be removed and replaced at the Applicant's expense.

2. The District shall have the right to enter upon the Applicant's property to inspect, repair, or replace any equipment used in connection with the District's service or which may interfere with said service.

3. The Applicant shall be responsible for all monthly user rates, capacity charges, and tap fees. The failure to pay any rate charge or fee may result in a lien against the property and/or the termination of service to the property, the cost of which will be borne by Applicant, including, but not limited to, all attorney's fees and collection costs.

4. The District shall not be responsible for any damages as a result of any failure to supply service unless said damages are due to default, neglect or culpability on the part of the District.

5. If there is an available sanitary sewer within three hundred (300) feet of the property line, the property owner shall be required to connect to the District's sanitary sewer system.

6. The Applicant and District agree that the provision of sanitary sewer service touches and concerns the property and the terms of this Agreement bind the District and Applicant and their heirs, executors, administrators, personal representatives, successors, agents, attorneys, assigns, designees, and transferees.

The parties hereto have read and fully understand the above provisions and agree to comply with said provisions.

FALL CREEK REGIONAL WASTE DISTRICT
Libbra Wilson
Signature

APPLICANT
Paul E Stephens
Signature

STATE OF INDIANA)
) SS:
COUNTY OF MADISON)

SUBSCRIBED and sworn to before me this 7th day of March, 2001.

My Commission Expires:
2-20-08

Signature Deborah L. Wilson
Printed Deborah L. Wilson
Notary Public
Resident of Madison County

INSPECTOR B DATE INSPECTED 9-18-0 APPROVED ✓ REJECTED

REASON FOR REJECTION

DATE REINSPECTED APPROVED REJECTED

NOTES:
SIZE PIPE 6 TYPE PIPE PVC

BASEMENT YES NO X

SUMP PUMP YES NO X

DOWNSPOUT TO GROUND YES X NO


SEPTIC TANK PUMPED & FILLED YES X NO

CONTRACTOR TEO

SPECIAL CONDITIONS

EXISTING HOME X

NEW CONSTRUCTION

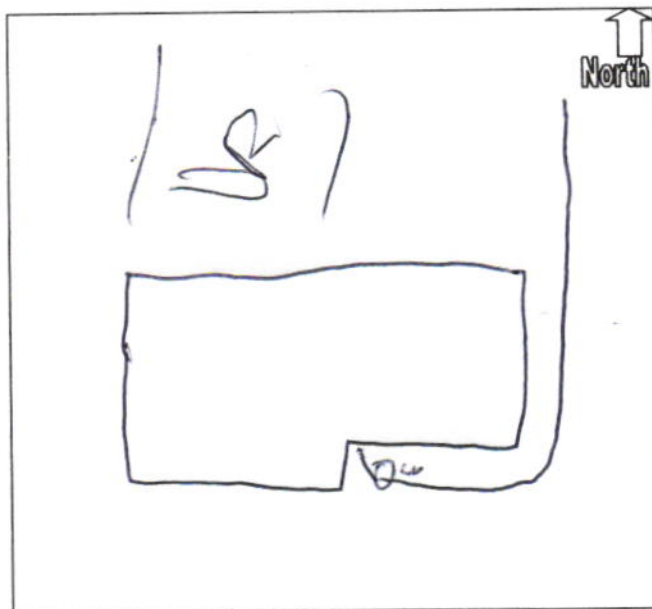

PAUL E STEVENS 10-98
2559 W TODD LN, PH (765) 778-7034
ANDERSON, IN 46013-9738

0161

71-167/749
BRANCH 10006

3-7-8 Date

Pay to the order of FALL CREEK REGIONAL WASTE

\$ 1926 ⁸⁵/₁₀₀


ONE THOUSAND NINE HUNDRED & TWENTY SIX ⁸⁵/₁₀₀

 **STAR**
Financial Bank

PREFERRED LIQUIDITY ACCOUNT

 Security
Features
Details on
Back

For _____

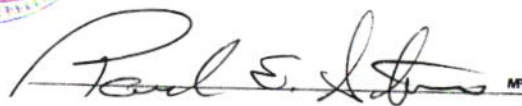 MP