

# FALL CREEK REGIONAL WASTE DISTRICT

9378 S 650 WEST, P.O. BOX 59, PENDLETON, IN 46064

765-778-7544

## AGREEMENT FOR SANITARY SEWER SERVICE

This Agreement made and entered into this 10<sup>th</sup> day of August, 200 1, between FALL CREEK REGIONAL WASTE DISTRICT ("District") and May Mercer ("Applicant") regarding the provision of sanitary sewer service, and the assignment of capacity in, and connection to, the District's facilities for the premises located at 2597 W. Mercer.

NOW THEREFORE, the parties, in consideration of the mutual promises set forth and sufficiency of which is hereby acknowledged, agree as follows:

1. The Applicant agrees that all workmanship and materials shall conform to the District's construction standards. District must accept and approve all work and materials before connection is made to the sewer mains. Any violation of this provision will cause all work to be removed and replaced at the Applicant's expense.
2. The District shall have the right to enter upon the Applicant's premises at all reasonable times to inspect, repair, or replace any equipment used in connection with the District's service or which has an impact on said service.
3. The Applicant shall be responsible for all monthly user rates, capacity charges, and tap fees. The failure to pay any rate charge or fee may result in a lien against the property and/or the termination of service to the property, the cost of which will be borne by Applicant, including, but not limited to, all attorney's fees and collection costs.
4. The District shall not be responsible for any damages as a result of any failure to supply service unless said damages are due to default, neglect or culpability on the part of the District.
5. If there is an available sanitary sewer within three hundred (300) feet of the property line, the property owner shall be required to connect to the District's sanitary sewer system.
6. The Applicant and District agree that the provision of sanitary sewer service touches and concerns the property and the terms of this Agreement bind the District and Applicant and their heirs, executors, administrators, personal representatives, successors, agents, attorneys, assigns, designees, and transferees.

The parties hereto have read and fully understand the above provisions and agree to comply with said provisions.

FALL CREEK REGIONAL WASTE DISTRICT

Jan E. Carey  
Signature

APPLICANT

May D. Mercer  
Signature

STATE OF INDIANA )  
 ) SS:  
COUNTY OF MADISON )

SUBSCRIBED and sworn to before me this 13<sup>th</sup> day of August, 200 1.

My Commission Expires:  
4-29-2009

Signature Jan E. Carey

Printed Jan E. Carey

Notary Public  
Resident of Madison County

\*\*\*\*\*

INSPECTOR T DATE INSPECTED 8-30-01 APPROVED \_\_\_\_\_ REJECTED \_\_\_\_\_

REASON FOR REJECTION \_\_\_\_\_

DATE REINSPECTED \_\_\_\_\_ APPROVED \_\_\_\_\_ REJECTED \_\_\_\_\_

### NOTES:

SIZE PIPE 4" 1 1/2 TYPE PIPE 35 / 160

BASEMENT YES \_\_\_\_\_ NO ☒

SUMP PUMP YES \_\_\_\_\_ NO ☒

DOWNSPOUT TO GROUND YES ☒ NO \_\_\_\_\_

SEPTIC TANK PUMPED & FILLED YES ☒ NO \_\_\_\_\_


CONTRACTOR Self

SPECIAL CONDITIONS Garage Rental

EXISTING HOME ☒

GARAGE

NEW CONSTRUCTION \_\_\_\_\_

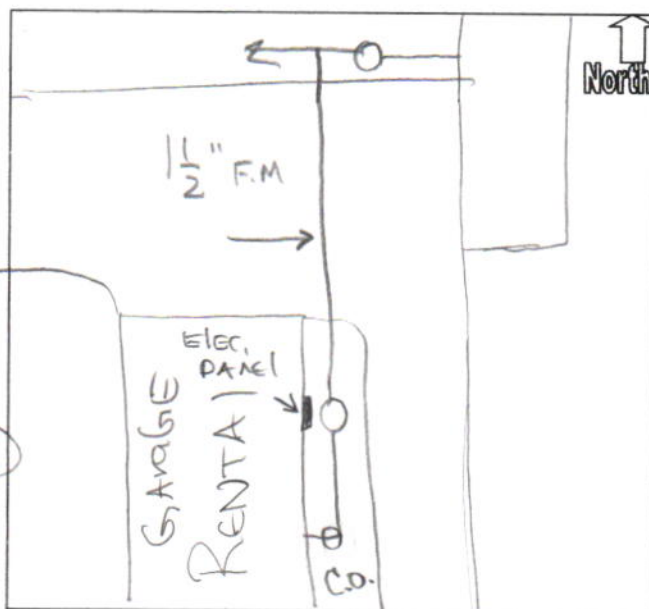

MAX D MERCER 8/84  
314-34-5651  
2584 W MERCER DR PH 778-4206  
PENDLETON, IN 46064

2882  
71-7257/2749  
DATE 8-10-01

PAY TO THE  
ORDER OF

S. C. R. W. D.

\$ 6100.<sup>00</sup>

Six Thousand One Hundred <sup>00</sup>/<sub>100</sub>

DOLLARS  Security features  
included  
Details on back.

**INDEPENDENT** **FEDERAL**  
CREDIT UNION

ANDERSON, INDIANA 46016

FOR

Tap Fees

Max D. Mercer MP

⑆274972579⑆

2882

CHPLAND