

FALL CREEK REGIONAL WASTE DISTRICT

9378 S 650 WEST, P.O. BOX 59, PENDLETON, IN 46064

765-778-7544

AGREEMENT FOR SANITARY SEWER SERVICE

add order  
on file  
4042

26-04600.00

This Agreement made and entered into this 27<sup>th</sup> day of Feb., 2001, between FALL CREEK REGIONAL WASTE DISTRICT ("District") and Terrin + Julie Nice ("Applicant") regarding the provision of sanitary sewer service, and the assignment of capacity in, and connection to, the District's facilities for the premises located at 2601 West Woodlawn

NOW THEREFORE, the parties, in consideration of the mutual promises set out in this Agreement, the receipt and sufficiency of which is hereby acknowledged, agree as follows:

1. The Applicant agrees that all workmanship and materials shall conform to all District ordinances and the District's construction standards. District must accept and approve all work and materials before backfilling and final connection is made to the sewer mains. Any violation of this provision will cause all lines and appurtenances in violation to be removed and replaced at the Applicant's expense.
2. The District shall have the right to enter upon the Applicant's premises at all reasonable times to inspect, repair, or replace any equipment used in connection with the District's service or which has an impact on said service.
3. The Applicant shall pay the District monthly user rates, capacity charges, and tap fees. The failure to pay any such amount shall constitute a lien against the property and/or the termination of service to the property, the cost of which shall include, but not limited to, all attorney's fees and collection costs.
4. The District shall not be liable for damages as a result of any failure to supply service unless said damages are caused by negligence on the part of the District.
5. If there is a sanitary sewer within three hundred (300) feet of the property line, the property owner shall be required to connect to the District's sanitary sewer system.
6. The Applicant and District agree that the provision of sanitary sewer service touches and concerns the property and the terms of this Agreement bind the District and Applicant and their heirs, executors, administrators, personal representatives, successors, agents, attorneys, assigns, designees, and transferees.

The parties hereto have read and fully understand the above provisions and agree to comply with said provisions.

FALL CREEK REGIONAL WASTE DISTRICT

Signature

APPLICANT

Signature

STATE OF INDIANA )

) SS:

COUNTY OF MADISON )

SUBSCRIBED and sworn to before me this 27<sup>th</sup> day of February, 2001.

My Commission Expires:

2-20-2008

Signature

Printed

Notary Public

Resident of Madison County

INSPECTOR B DATE INSPECTED 3-2-1 APPROVED ✓ REJECTED \_\_\_\_\_

REASON FOR REJECTION \_\_\_\_\_

DATE REINSPECTED \_\_\_\_\_ APPROVED \_\_\_\_\_ REJECTED \_\_\_\_\_

NOTES:

SIZE PIPE 6" TYPE PIPE PVC SDR 26

BASEMENT YES \_\_\_\_\_ NO X

SUMP PUMP YES \_\_\_\_\_ NO X

DOWNSPOUT TO GROUND YES X NO \_\_\_\_\_


SEPTIC TANK PUMPED & FILLED YES X NO \_\_\_\_\_

CONTRACTOR Bietz

SPECIAL CONDITIONS \_\_\_\_\_

EXISTING HOME X

NEW CONSTRUCTION \_\_\_\_\_

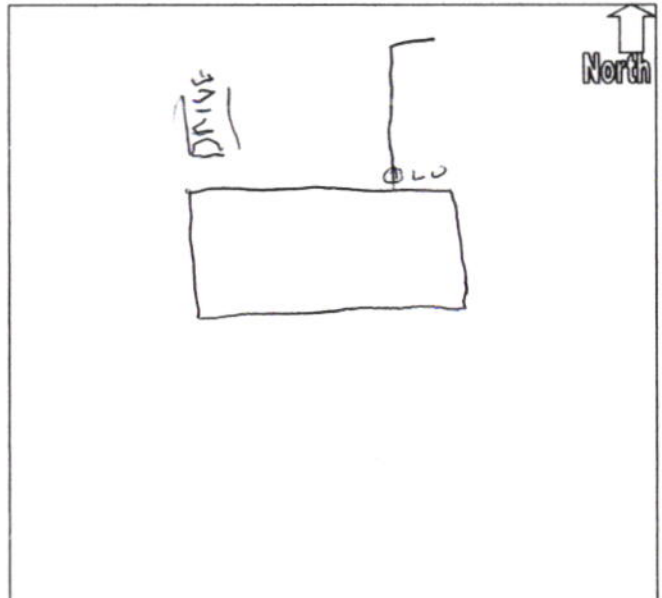



FERRIN L. NICE 01-90  
JULIE K. NICE  
PH 778-4935  
2601 WEST WOODLAWN DR  
ANDERSON, IN 46013-9629

4698

20-6/740 305

Feb. 26, 2001 Date

Pay to the  
Order of

Fall Creek Regional Waste

\$ 1926.91

One thousand nine hundred and twenty six dollars and 91/100

Dollars

**National City.**

National City Bank of Indiana  
Anderson, Indiana

For

Julie K. Nice  
4698

⑆074000065⑆

© HARLAND

PRESTI