

add order
on file

FALL CREEK REGIONAL WASTE DISTRICT

4071

9378 S 650 WEST, P.O. BOX 59, PENDLETON, IN 46064

765-778-7544

26-03470.01

AGREEMENT FOR SANITARY SEWER SERVICE

This Agreement made and entered into this 5th day of March, 2001, between FALL CREEK REGIONAL WASTE DISTRICT ("District") and Lori Cleverger ("Applicant") regarding the provision of sanitary sewer service, and the assignment of capacity in, and connection to, the District's facilities for the premises located at 2618 Ted Lane.

NOW THEREFORE, the parties, in consideration of the mutual promises set out in this Agreement, the receipt and sufficiency of which is hereby acknowledged, agree as follows:

1. The Applicant agrees that all workmanship and materials shall conform to all District ordinances and the District's construction standards. All work and materials before backfilling and final connection is made to the sewer main will cause all lines and appurtenances in violation to be removed and replaced at the Applicant's expense.

2. The District shall have the right to enter the Applicant's premises at all reasonable times to inspect, repair, or replace any equipment or appurtenances which are necessary for the District's service or which has an impact on said service.

3. The Applicant shall pay all rates, capacity charges, and tap fees. The failure to pay any rate charge or fee may result in a lien against the property and/or the termination of service to the property, the cost of which will be borne by Applicant, including, but not limited to, all attorney's fees and collection costs.

4. The District shall not be responsible for any damages as a result of any failure to supply service unless said damages are due to default, neglect or culpability on the part of the District.

5. If there is an available sanitary sewer within three hundred (300) feet of the property line, the property owner shall be required to connect to the District's sanitary sewer system.

6. The Applicant and District agree that the provision of sanitary sewer service touches and concerns the property and the terms of this Agreement bind the District and Applicant and their heirs, executors, administrators, personal representatives, successors, agents, attorneys, assigns, designees, and transferees.

The parties hereto have read and fully understand the above provisions and agree to comply with said provisions.

FALL CREEK REGIONAL WASTE DISTRICT

APPLICANT

Signature

Signature

STATE OF INDIANA)

) SS:

COUNTY OF MADISON)

SUBSCRIBED and sworn to before me this _____ day of _____, 200____.

My Commission Expires:

Signature

Printed

Notary Public
Resident of Madison County

INSPECTOR Bra DATE INSPECTED 4-10-1 APPROVED ✓ REJECTED ✓

REASON FOR REJECTION Wrong Stone

DATE REINSPECTED 4-10-1 APPROVED ✓ REJECTED PER Tim McCurdy

NOTES: 6 TYPE PIPE PVC

BASEMENT YES NO X

SUMP PUMP YES NO X

DOWNSPOUT TO GROUND YES X NO ?


SEPTIC TANK PUMPED & FILLED YES NO X

CONTRACTOR Dick Godbey

SPECIAL CONDITIONS

EXISTING HOME X

NEW CONSTRUCTION

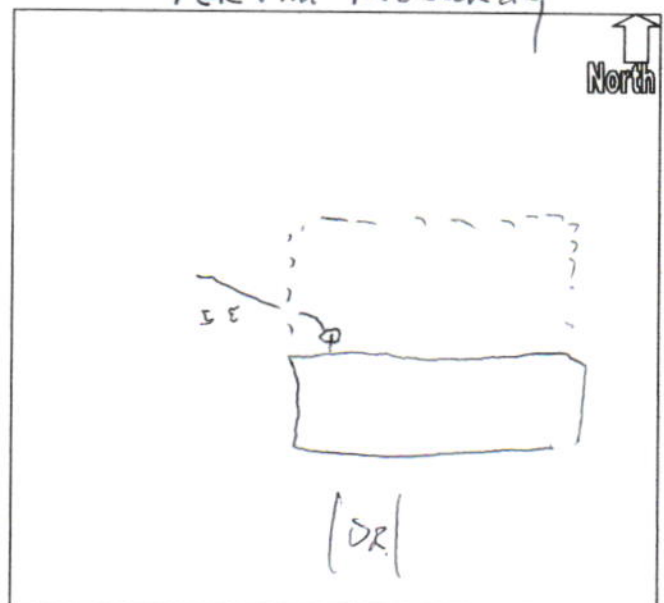



FIRST INDIANA BANK

OFFICIAL CHECK

1710157

20-7043 / 2740

Date: MARCH 02, 2001

Pay to the
Order of:

*** FALL CREEK REGIONAL WASTE DIT. ***

\$ 2,091.05

*** TWO THOUSAND NINETY-ONE AND 05/100 ***

Remitter:

Authorized Signature

⑈ 1710157⑈ ⑆ 274070439⑆ 900000016⑈