

FALL CREEK REGIONAL WASTE DISTRICT

9378 S 650 WEST, P.O. BOX 59, PENDLETON, IN 46064
765-778-7544

AGREEMENT FOR SANITARY SEWER SERVICE

This Agreement made and entered into this 18th day of October, 2002, between FALL CREEK REGIONAL WASTE DISTRICT ("District") and Bert & Sandy Payne ("Applicant") regarding the provision of sanitary sewer service, and the assignment of capacity/in, and connection to, the District's facilities for the premises located at 2627 E Hog 38.

NOW THEREFORE, the parties, in consideration of the mutual promises set out in this Agreement, the receipt and sufficiency of which is hereby acknowledged, agree as follows:

1. The Applicant agrees that all workmanship and materials shall conform to all District ordinances and the District's construction standards. District must accept and approve all work and materials before backfilling and final connection is made to the sewer mains. Any violation of this provision will cause all lines and appurtenances in violation to be removed and replaced at the Applicant's expense.
2. The District shall have the right to enter upon the Applicant's premises at all reasonable times to inspect, repair, or replace any equipment used in connection with the District's service or which has an impact on said service.
3. The Applicant shall be responsible for all monthly user rates, capacity charges, and tap fees. The failure to pay any rate charge or fee may result in a lien against the property and/or the termination of service to the property, the cost of which will be borne by Applicant, including, but not limited to, all attorney's fees and collection costs.
4. The District shall not be responsible for any damages as a result of any failure to supply service unless said damages are due to default, neglect or culpability on the part of the District.
5. If there is an available sanitary sewer within three hundred (300) feet of the property line, the property owner shall be required to connect to the District's sanitary sewer system.
6. The Applicant and District agree that the provision of sanitary sewer service touches and concerns the property and the terms of this Agreement bind the District and Applicant and their heirs, executors, administrators, personal representatives, successors, agents, attorneys, assigns, designees, and transferees.

The parties hereto have read and fully understand the above provisions and agree to comply with said provisions.

FALL CREEK REGIONAL WASTE DISTRICT

Signature

APPLICANT

Signature

STATE OF INDIANA)
) SS:
COUNTY OF MADISON)

SUBSCRIBED and sworn to before me this 18th day of October, 2002.

My Commission Expires:

4-29-09

Signature

Printed

Notary Public

Resident of Madison County

INSPECTOR Don DATE INSPECTED 11/27/02 APPROVED ✓ REJECTED _____

REASON FOR REJECTION _____

1 1/2 fm

DATE REINSPECTED _____

APPROVED NA

REJECTED _____

NOTES:

SIZE PIPE 4" LAF

TYPE PIPE SDR35 / 160 PSI

BASEMENT YES ✓ NO _____

SUMP PUMP YES ✓ NO _____

DOWNSPOUT TO GROUND YES NO

SEPTIC TANK PUMPED & FILLED YES NO


CONTRACTOR Drck Godbey Const.

SPECIAL CONDITIONS * DRAWING NOT ACCURATE *

EXISTING HOME _____

NEW CONSTRUCTION ✓

JOB WAS BACK FILLED AT TIME
OF INSPECTION: PER
TYPICAL Drck Godbey
JOB!

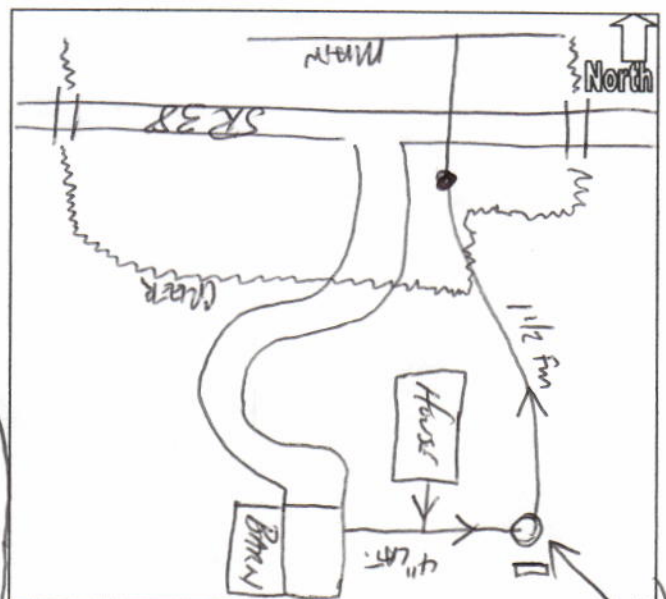

DR. ALBERT M. PAYNE
SANDRA H. PAYNE
PH. 770-535-0010
5567 MALLARD WALK
GAINESVILLE, GA 30504

64-1/610

5031

DATE 10/18/02

PAY TO THE
ORDER OF

FCRWD

\$ 3,659⁸⁰

Three thousand six hundred fifty nine and 80/100

WACHOVIA BANK, N.A.
GAINESVILLE, GA 30503

FOR

Gunder +
top capacity

Sandra Payne

⑆06⑆0000⑆0⑆

5031