




7965 East 106th Street, Fishers, IN 46038-2505
phone: 317.849.5935 fax: 317.849.5942

CONTROL# 97224 DRH

273 CARRICK GLEN BOULEVARD
PENDLETON, IN 46064

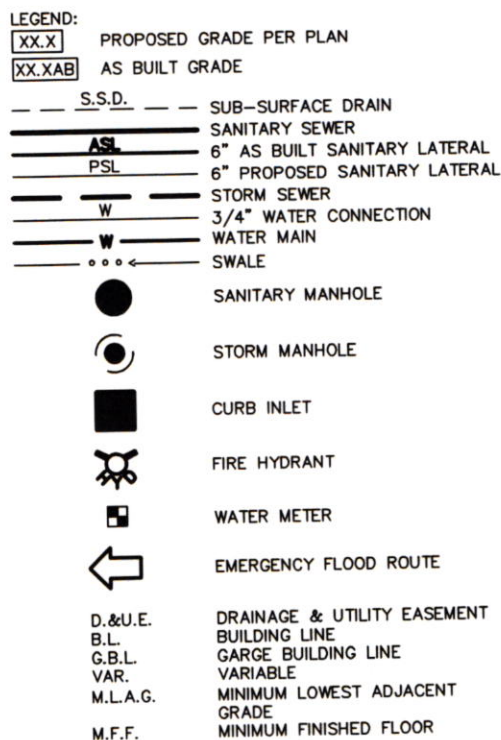

LOT COVERAGE=32.5%
M.L.A.G.=872.4
M.F.F.=874.5

CARRICK GLEN
BOULEVARD

LOT 67
CARRICK GLEN
SECTION 2

INST. #2021R000943
ZONING: SINGLE FAMILY
5' MINIMUM SIDE YARD
15' MINIMUM REAR YARD
50% MAXIMUM LOT COVERAGE

BENCHMARK
TOP OF CASTING = 874.40

ALL UNDERGROUND SEWERS AND UTILITIES
SHOWN ARE PLOTTED BY SCALE FROM
DESIGN PLANS FURNISHED BY ENGINEER.
THE ACTUAL FIELD LOCATION MAY VARY.

SOD: 1,593 ± Sq. Ft.
SEEDING: 4,258 ± Sq. Ft.
CONC. DRIVEWAY: 558 ± Sq. Ft.
PRIVATE WALK: 29 ± Sq. Ft.
PUBLIC WALK: 239 ± Sq. Ft.

A circular professional seal for David J. Stoeppelwerth, a Registered Professional Surveyor in the State of Indiana. The seal features the name "DAVID J. STOEPPELWERTH" around the top inner edge, "REGISTERED" at the top, "No. 80040474" in the center, "STATE OF INDIANA" below the number, and "LAND SURVEYOR" around the bottom inner edge. The entire seal is enclosed in a double-lined circular border.

David J. Stoesselwerth

NOTE: THIS DRAWING IS NOT INTENDED TO BE REPRESENTED AS A RETRACEMENT OR ORIGINAL BOUNDARY SURVEY, A ROUTE SURVEY OR A SURVEYOR LOCATION REPORT.

03/28/21 EMC



Carrick Glen Lot #67


Wills Exv.

6/30/21

22

273 Carrick Glen Blvd.

1 ← 5' → 3' ↑

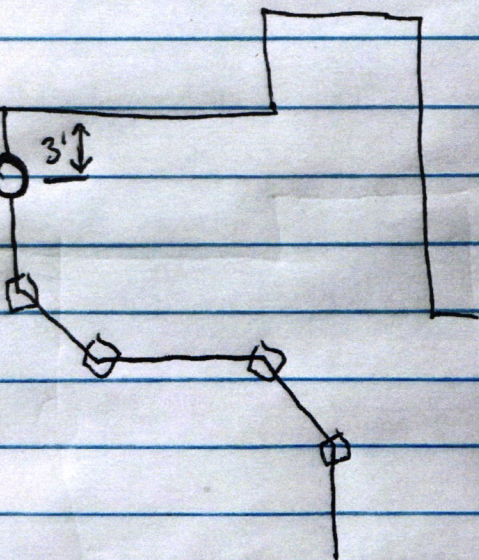





THIS CHECK IS PRINTED IN RED AND BLUE INK ON THE FACE ON CHEMICAL AND BLEACH REACTIVE PAPER WITH INVISIBLE FLUORESCENT FIBERS AND BASKETWEAVE ON BACK

D.R. HORTON
America's Builder

DRH Inc. Controlled Disb
1341 Horton Circle
Arlington, TX 76011

JP Morgan Chase Bank, N.A.
Syracuse, NY

Check Number 1265404

50-937

213

2720128

Date	Amount
03/17/21	\$*****760.00

Void after 6 months from date of issue

SEVEN HUNDRED SIXTY AND 00/100 *****

Pay To The Order Of:
FALL CREEK REGIONAL WASTE DISTRICT
9378 SOUTH 650 WEST
PENDLETON IN 46064

D.L. Horton

Rec # 011645

COPY