

add order
on file

4373

26-14180.01

FALL CREEK REGIONAL WASTE DISTRICT

9378 S 650 WEST, P.O. BOX 59, PENDLETON, IN 46064

765-778-7544

AGREEMENT FOR SANITARY SEWER SERVICE

This Agreement made and entered into this 9th day of May, 2001, between FALL CREEK REGIONAL WASTE DISTRICT ("District") and Michael Cloud ("Applicant") regarding the provision of sanitary sewer service, and the assignment of capacity in, and connection to, the District's facilities for the premises located at 2647 W. Ridge Lane

NOW THEREFORE, the parties, in consideration of the mutual promises set out in this Agreement, the receipt and sufficiency of which is hereby acknowledged, agree as follows:

1. The Applicant agrees that all workmanship and materials shall conform to all District ordinances and the District's construction standards. District must accept and approve all work and materials before backfilling and final connection is made to the sewer mains. Any violation of District ordinances and appurtenances in violation to be removed and replaced at the Applicant's expense.

2. The District shall have the right to enter upon the property at reasonable times to inspect, repair, or replace any equipment used in connection with the service which has an impact on said service.

3. The Applicant shall be responsible for all meter and tap fees. The failure to pay any rate charge or fee may result in a termination of service to the property, the cost of which will be borne by Applicant, including, but not limited to, all attorney's fees and collection costs.

4. The District shall not be responsible for any damages as a result of any failure to supply service unless said damages are due to default, neglect or culpability on the part of the District.

5. If there is an available sanitary sewer within three hundred (300) feet of the property line, the property owner shall be required to connect to the District's sanitary sewer system.

6. The Applicant and District agree that the provision of sanitary sewer service touches and concerns the property and the terms of this Agreement bind the District and Applicant and their heirs, executors, administrators, personal representatives, successors, agents, attorneys, assigns, designees, and transferees.

The parties hereto have read and fully understand the above provisions and agree to comply with said provisions.

FALL CREEK REGIONAL WASTE DISTRICT

Signature Chris Carey

APPLICANT

Signature Michael Cloud

STATE OF INDIANA)

) SS:

COUNTY OF MADISON)

SUBSCRIBED and sworn to before me this 9th day of May, 2001.

My Commission Expires: 2-20-2008

Signature Deborah L. Wilson

Printed Deborah L. Wilson

Notary Public
Resident of Madison County

INSPECTOR Steve DATE INSPECTED 5/9/01 APPROVED ✓ REJECTED _____

REASON FOR REJECTION _____

DATE REINSPECTED _____ APPROVED _____ REJECTED _____

NOTES:

SIZE PIPE 6" TYPE PIPE SDR 35

BASEMENT YES NO

SUMP PUMP YES NO

DOWNSPOUT TO GROUND YES NO


SEPTIC TANK PUMPED & FILLED YES NO ?

CONTRACTOR Fredericks

SPECIAL CONDITIONS _____

EXISTING HOME ✓

NEW CONSTRUCTION _____

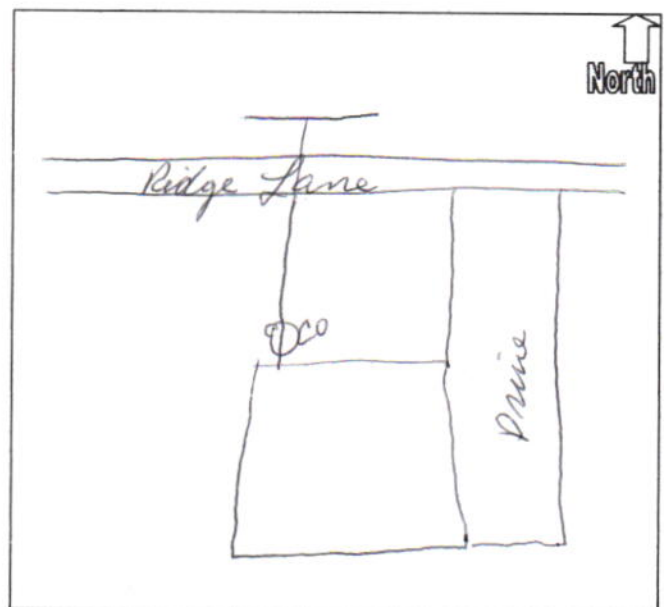


MICHAEL J CLOUD
MARY A CLOUD
2647 W RIDGE LN
ANDERSON IN 46013

Equity Reserve

1004

Date May 9, 2001

6-12/410

Pay to the order of FCRWD \$ 2036³⁵
Two thousand thirty six and 35/100 Dollars  Security features included. Details on back.

National City®
National City Bank
CLEVELAND, OHIO

For Capacity Fee

Michael J Cloud MP
1004

© HARLAND