

4342

9378 S 650 WEST, P.O. BOX 59, PENDLETON, IN 46064

765-778-7544

26-04200.00

## AGREEMENT FOR SANITARY SEWER SERVICE

This Agreement made and entered into this 2<sup>ND</sup> day of May, 2001, between FALL CREEK REGIONAL WASTE DISTRICT ("District") and Michael Heathcote ("Applicant") regarding the provision of sanitary sewer service, and the assignment of capacity in, and connection to, the District's facilities for the premises located at 2677 W. Ridge Lane.

**NOW THEREFORE**, the parties, in consideration of the mutual promises set out in this Agreement, the receipt and sufficiency of which is hereby acknowledged, agree as follows:

1. The Applicant agrees that all workmanship and materials shall conform to all District ordinances and the District's construction standards. District must accept and approve all work and materials before backfilling and final connection is made to the sewer mains. Any violation of this provision will cause all lines and appurtenances in violation to be removed and replaced at the Applicant's expense.
2. The District shall have the right to enter upon the Applicant's premises at all reasonable times to inspect, repair, or replace any equipment used in connection with the District's service or which has an impact on said service.
3. The Applicant shall be responsible for all monthly user rates, capacity charges, and tap fees. The failure to pay any rate charge or fee may result in a lien against the property and/or the termination of service to the property, the cost of which will be borne by Applicant, including, but not limited to, all attorney's fees and collection costs.
4. The District shall not be responsible for any damages as a result of any failure to supply service unless said damages are due to default, neglect or culpability on the part of the District.
5. If there is an available sanitary sewer within three hundred (300) feet of the property line, the property owner shall be required to connect to the District's sanitary sewer system.
6. The Applicant and District agree that the provision of sanitary sewer service touches and concerns the property and the terms of this Agreement bind the District and Applicant and their heirs, executors, administrators, personal representatives, successors, agents, attorneys, assigns, designees, and transferees.

The parties hereto have read and fully understand the above provisions and agree to comply with said provisions.

FALL CREEK REGIONAL WASTE DISTRICT

Signature \_\_\_\_\_

APPLICANT

Signature \_\_\_\_\_

STATE OF INDIANA )  
 ) SS:  
COUNTY OF MADISON)

SUBSCRIBED and sworn to before me this \_\_\_\_\_ day of \_\_\_\_\_, 200\_\_\_\_\_.

My Commission Expires:

Signature \_\_\_\_\_

Printed \_\_\_\_\_

Notary Public  
Resident of Madison County

\*\*\*\*\*  
INSPECTOR AS DATE INSPECTED 5-2-01 APPROVED ✓ REJECTED \_\_\_\_\_

REASON FOR REJECTION \_\_\_\_\_

<u>DATE REINSPECTED</u>	<u>APPROVED</u>	<u>REJECTED</u>
-------------------------	-----------------	-----------------

NOTES: SIZE PIPE 6 TYPE PIPE 35

BASEMENT YES NO X

SUMP PUMP YES NO ☒

DOWNSPOUT TO GROUND YES ☒ NO


SEPTIC TANK PUMPED & FILLED YES ☒ NO ☐

CONTRACTOR GARY

SPECIAL CONDITIONS

EXISTING HOME ☒

NEW CONSTRUCTION

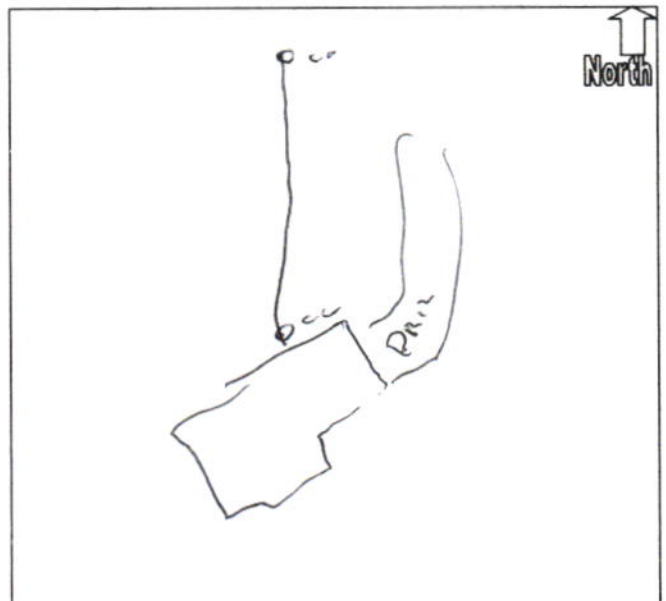



**GERRY'S CONSTRUCTION SERVICE**

TIN#35-2048835  
4424 E. 575 S.  
MARKLEVILLE, IN 46056  
(765) 779-4269

4504

71-553/749  
BRANCH 1

DATE 5-2-01 <sup>04.</sup>

PAY  
TO THE  
ORDER OF

*Fall Creek Beyond  
from hundred dollar*

\$ 408

DOLLARS  Security features  
included.  
Details on back.



**Madison  
Community Bank**

FOR

*Heatrate + tag fee*

*[Signature]*

MP

⑈004504⑈ ⑆074905539⑆

MICHAEL C HEATHCOTE 1-84  
OR SIGRIDA M HEATHCOTE  
2677 W RIDGE LN  
ANDERSON, IN 46013-9781  
(765) 778-2794




8879

DATE May 9, 01

71-167/749  
BRANCH 10006

PAY TO THE  
ORDER OF


Fall Creek Regional Waste \$ 1444.90  
One Thousand Four Hundred Forty Four and 00/100 DOLLARS  Security features  
included.  
Details on back.



**STAR**  
Financial Bank

GENERATIONS GOLD MEMBER

FOR

Sigrida M Heathcote 

⑆074901672⑆ 8879

© HARLAND 1996