

add Order
on file

26-04660.00

AGREEMENT FOR SANITARY SEWER SERVICE

NOW THEREFORE, the parties, in consideration of the mutual promises set out in this Agreement, the receipt and sufficiency of which is hereby acknowledged, agree as follows:

1. The Applicant agrees that all workmanship and materials shall conform to all District ordinances and the District's construction standards. District must accept and approve all work and materials before backfilling and final connection is made to the sewer mains. Any violation of this provision will cause all lines and appurtenances in violation to be removed and replaced at the Applicant's expense.
2. The District shall have the right to inspect, repair, or replace the sewer service on the Applicant's premises at all reasonable times to the extent necessary for the maintenance of the District's service or which has an impact on said service.
3. The Applicant shall pay the District's reasonable user rates, capacity charges, and tap fees. The failure to pay any rate or fee shall be cause for suspension of service and/or the termination of service to the property, the cost of which shall be borne by the Applicant, but not limited to, all attorney's fees and collection costs.
4. The District shall not be responsible for damages as a result of any failure to supply service unless said damages are due to default, neglect or culpability on the part of the District.
5. If there is an available sanitary sewer within three hundred (300) feet of the property line, the property owner shall be required to connect to the District's sanitary sewer system.
6. The Applicant and District agree that the provision of sanitary sewer service touches and concerns the property and the terms of this Agreement bind the District and Applicant and their heirs, executors, administrators, personal representatives, successors, agents, attorneys, assigns, designees, and transferees.

APPLICANT

Signature _____

SUBSCRIBED and sworn to before me this 20th day of April, 2001

Signature

Printed

Notary Public

Resident of Madison County

INSPECTOR Steve DATE INSPECTED 4/20/01 APPROVED ✓ REJECTED

REASON FOR REJECTION

DATE REINSPECTED _____ APPROVED _____ REJECTED _____

NOTES:

SIZE PIPE 6" TYPE PIPE SDR 35

BASEMENT YES NO

SUMP PUMP YES ☒ NO

DOWNSPOUT TO GROUND ☒ YES ☐ NO


SEPTIC TANK PUMPED & FILLED YES ☒ NO ☐

CONTRACTOR *Nedrusks*

SPECIAL CONDITIONS 50 Rt from well

EXISTING HOME ☒

NEW CONSTRUCTION

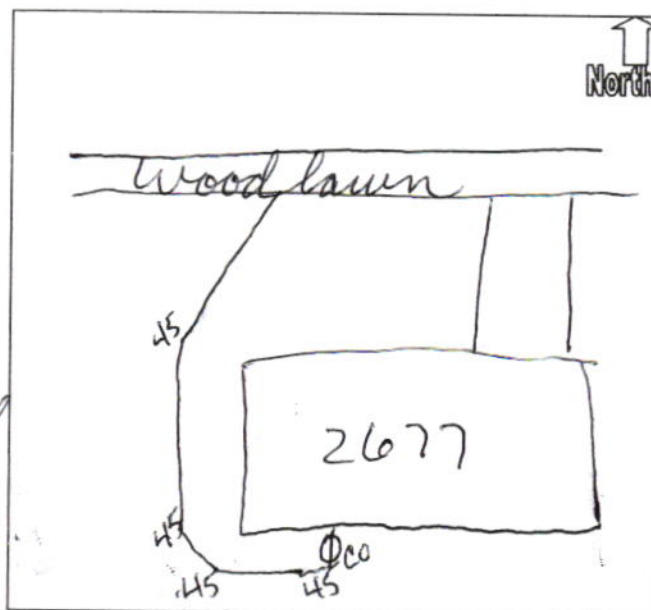

GRAYDON D. SKEOCH, TRUSTEE
CINDY W. SKEOCH, TRUSTEE
2677 WOODLAWN DR. 765-778-4367
ANDERSON, IN 46013

2341

Date 4/20/01

71-7258/2749
00

Pay to the
Order of FCRWD

\$ 400⁰⁰/₁₀₀

Four hundred ⁰⁰/₁₀₀

Dollars

 Security features
are included.
Details on back.



FEDERAL CREDIT UNION
2115 WEST 25TH STREET - ANDERSON, INDIANA 46016

For _____

Cindy W. Skeoch ^{MP}

⑆ 274972582⑆

2341

GRAYDON D. SKEOCH, TRUSTEE
CINDY W. SKEOCH, TRUSTEE
2677 WOODLAWN DR. 765-778-4367
ANDERSON, IN 46013

2384

Date 5/23/01

71-7258/2749
00

© 2001 American REGENT® WORE

Pay to the
Order of FC RWD

\$ 1444. ⁹⁰/₁₀₀

Fourteen hundred forty four ⁹⁰/₁₀₀ ————— Dollars

Security features
are included
Details on back



FEDERAL CREDIT UNION
2115 WEST 26TH STREET - ANDERSON, INDIANA 46016

For _____

Cindy W. Skeoch MP

⑆ 274972582⑆

2384