


7-1-19

White aspen

Fusion ex.

N Rehab

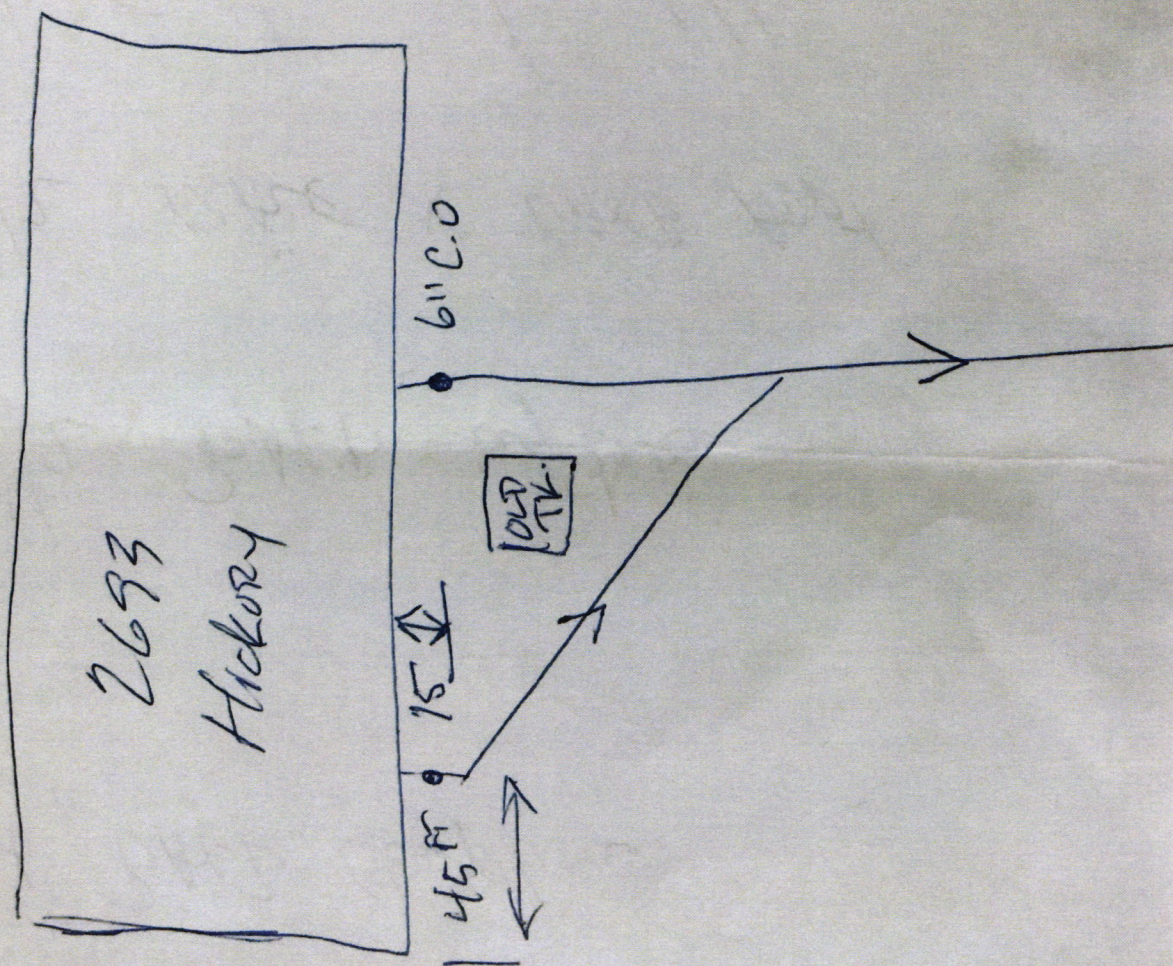



2693 W Hickory

Rehab

7.1.19

Don Moore

