



# FALL CREEK REGIONAL WASTE DISTRICT

Box 44, Pendleton, Indiana 46064

Approx. 6-30-89

1-0002925-00

Nº 001671

## APPLICATION FOR SEWER PERMIT

Permit No. \_\_\_\_\_ Date 4-12-89

Permit Void 90 days from Date of Issuance

Owner Name NANCY Miller

Property Address 26 MYRENIA DR

Lot # 2119 P.O. Box \_\_\_\_\_

Town Ingaills, IN Zip Code 46048

Phone \_\_\_\_\_ Water Meter \_\_\_\_\_

\$ 500.00 Tap on Fee Paid 100.00 5-23-89

\$ 25.00 Inspection fee paid 200.00 6-19-89  
125.00 6-26-89 7-3-89 *in full*

Application is hereby made for connection to the Fall Creek Regional Waste District Sewer System for the above listed property - Permit Type: Residential X, Commercial \_\_\_\_\_, Industrial \_\_\_\_\_, or Governmental/Institutional \_\_\_\_\_. User Information \_\_\_\_\_.

All workmanship and materials shall conform to the standards of the District Ordinance as described in Ordinance 84-2 and 84-3 as amended. Acceptance and approval must be made by the District inspector or his duly authorized representative before backfilling and final connection is made to the main sewer lines. Any violation of applicable regulations will cause all lines and appurtenances in violation to be removed and replaced at the owners expense.

The Fall Creek Regional Waste District is responsible for the inspection, approval of materials, and installation techniques only. All costs for materials and installation and any liabilities resulting from same is the sole responsibility of the property owner.

I have read and fully understand the above provisions and agree to comply by said provisions.

Nancy Miller  
APPLICANT(S) SIGNATURE

\*\*\*\*\*


INSPECTOR B

Date inspected 7-6-89 Approved ✓ Rejected \_\_\_\_\_

Reason for rejection \_\_\_\_\_

Date reinspected \_\_\_\_\_ Approved \_\_\_\_\_ Rejected \_\_\_\_\_

Notes:  
Size Pipe 6 "  
Type Pipe PVC  
Basement Yes \_\_\_\_\_ No X  
Sump Pump Yes \_\_\_\_\_ No X  
Downspout to Ground Yes X No \_\_\_\_\_  
Septic Tank Pumped & filled Yes \_\_\_\_\_ No X  
Contractor Wilson CONNER  
Special Conditions NEW TRAILER  
(Double wide)

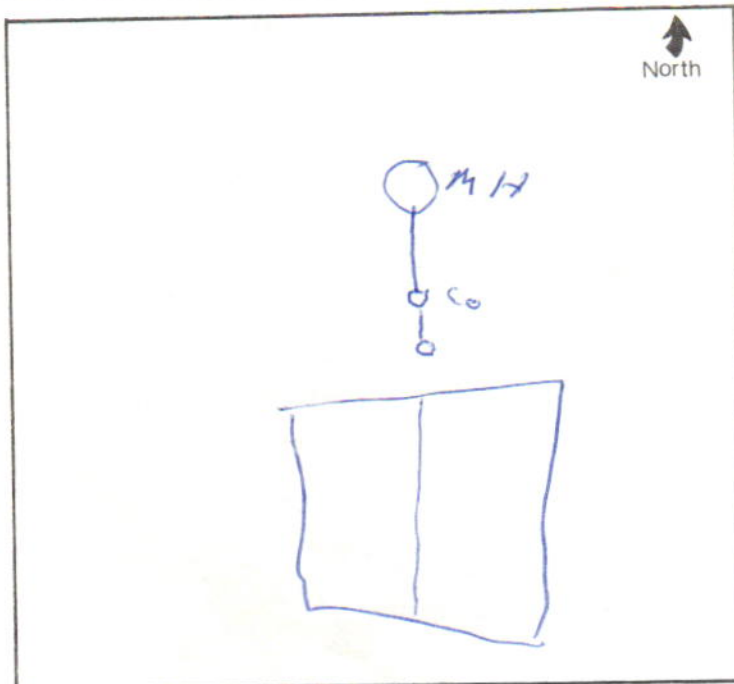



## FALL CREEK REGIONAL WASTE DISTRICT

Box 59, County Road 650 West, Pendleton, Indiana, 46064 (317) 778-3983

---

April 11, 1989

Nancy Miller  
5513 Wheel Estates  
West Drive  
Indianapolis, IN 46236

RE: Lot 21  
Inman Estates  
Ingalls, IN 46048

Dear Nancy:

Please find enclosed a payment book for the tap and inspection fees for the above referenced property.

The tap fee is \$500.00 and the inspection fee is \$25.00. As per our phone conversation, we are agreeing to payments of \$50.00 per month.

Please be advised that you will be responsible for hiring someone to install the line from your trailer to our main sewer line. When you do hire someone, they should contact our office for details of installation.

If you have questions, please call.

Respectfully,

Teresa Hutton  
Office Manager

tkh

enc.