
## #7825

Fall Creek Regional Waste District 9378 S 650 W, P.O. Box 59, Pendleton, IN 46064 765-778-7544

## **Agreement for Sanitary Sewer Service**

This Agreement made and entered into this <u>O</u> day of <u>Carrick</u> 2020, between Fall Creek Regional Waste District ("District") and <u>D.R. Horton/Westport Hornes</u> ("Applicant") regarding the provision of sanitary sewer service, and the assignment of capacity in and connection to, the District's facilities for the premises located at <u>Carrick Glen Lot 227</u> .	
Street Address: 270 WATERFORD LN.	
<b>Now therefore,</b> the parties, in consideration of the mutual promises set out in this Agreement, the receipt and sufficiency of which is hereby acknowledged, agree as follows:	
<ol> <li>The Applicant agrees that all workmanship and materials shall conform to all District ordinances and the District's construction standards. District must accept and approve all work and materials before backfilling and final connection is made to the sewer mains. Any violation of this provision will cause all lines and appurtenances in violation to be removed and replaced at the Applicant's expense.</li> </ol>	
<ol><li>The District shall have the right to enter upon the Applicant's premises at all reasonable times to inspect, repair, or replace any equipment used in connection with the District's service or which has an impact on said service.</li></ol>	
3. The Applicant shall be responsible for all monthly user rates, capacity charges, and tap fees. The failure to pay any rate charge or fee may result in a lien against the property and/or the termination of service to the property, the cost of which will be borne by Applicant, including, but not limited to, all attorney's fees and collection costs.	
<ul> <li>4. The District shall not be responsible for any damages as a result of any failure to supply service unless said damages are due to default, neglect or culpability on the part of the District.</li> <li>5. If there is an available sanitary sewer within three hundred (300) feet of the property line, the</li> </ul>	
property owner shall be required to connect to the District.  6. The Applicant and District agree that the provision of sconcerns the property and the terms of this Agreement heirs, executors, administrators, personal representative designees, and transferees.	rict's sanitary sewer system. sanitary sewer service touches and bind the District and Applicant and their
The parties hereto have read and fully understand the above provisions and agree to comply with said provisions.	
FALL CREEK REGIONAL WASTE DISTRICT	APPLICANT
Signature	Signature
STATE OF INDIANA ) ) SS: COUNTY OF MADISON )	
SUBSCRIBED and sworn to before me this day of, 20	
My Commission Expires: Signature	
Printed	
Notary Public  Resident of County  ***********************************	
Inspector Kyle Date Inspected (20/24 Approved_Reason for Rejecton	
Date Reinspected Approved Notes:	Rejected
Size Pipe 6 Type Pipe 80% 35 Basement Yes No	
	North
Sump Pump Yes (No)  Downspout to Ground Yes  Septic Tank Pumped & Filled Yes  Contractor (1) 115 (5) 27	
contractor 60 1113 Exo.	Drawing
Special Conditions	O
New Construction	+
	1 Picture
	attached



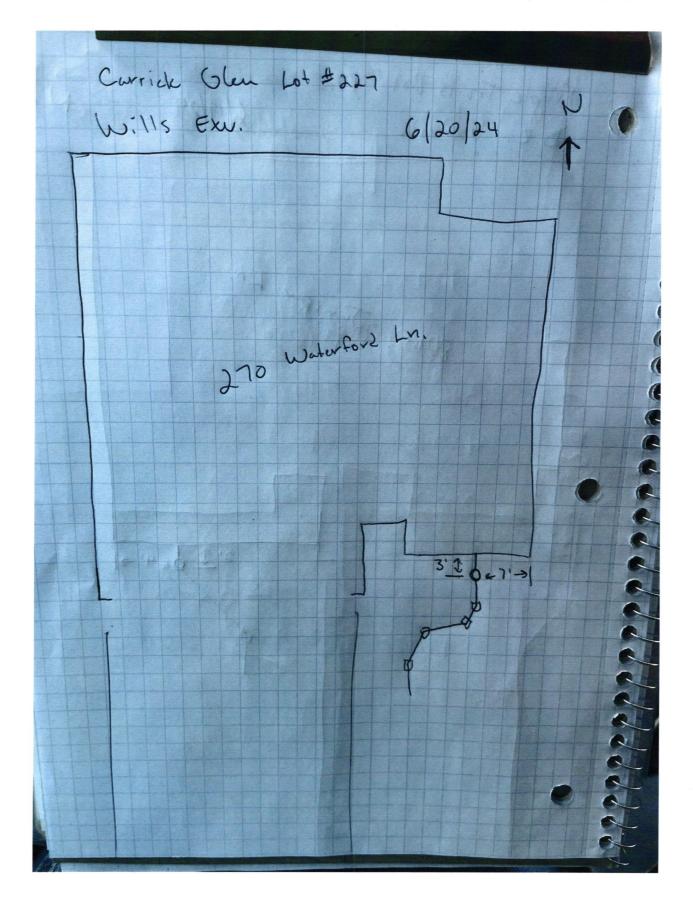

THIS CHECK IS PRINTED IN RED AND BLUE INK ON THE FACE ON CHEMICAL AND BLEACH REACTIVE PAPER WITH INVISIBLE FLUORESCENT FIBERS AND BASKETWEAVE ON BACK

D.R. HURTUN

DRH Inc. Controlled Disb 1341 Horton Circle Arlington, TX 76011 JP Morgan Chase Bank, N.A. Syracuse, NY

50-937 213

Date Amount
01/17/22 \$\*\*\*\*\*\*760.00
Void after 6 months from date of issue

**Check Number** 

2720128

SEVEN HUNDRED SIXTY AND 00/100 \*\*\*\*\*\*

Pay To The Order Of: FALL CREEK REGIONAL WASTE DISTRICT 9378 SOUTH 650 WEST PENDLETON IN 46064

D. L. Hocton

CG 227

1435383

PN0610