

John Arnold
22-23000.00



FALL CREEK REGIONAL WASTE DISTRICT

Box 44, Pendleton, Indiana 46064

2-0023000.00

No 001667

APPLICATION FOR SEWER PERMIT

Permit No. _____ Date 3-20-89

Permit Void 90 days from Date of Issuance

Owner Name Steve Paul

Property Address 371 W. U.S. 36 MAhogany Estates

Lot # 10 (271) P.O. Box 203

Town Pendleton, IN Zip Code 46064

Phone 842-1994 Water Meter Well

\$ 2880.00 Tap on Fee Paid \$25.00 will be deducted from money owed back to Steve
\$ PACP Inspection fee paid Paul.

Application is hereby made for connection to the Fall Creek Regional Waste District Sewer System for the above listed property - Permit Type: Residential ☒, Commercial ☐, Industrial ☐, or Governmental/Institutional ☐. User Information _____

All workmanship and materials shall conform to the standards of the District Ordinance as described in Ordinance 84-2 and 84-3 as amended. Acceptance and approval must be made by the District inspector or his duly authorized representative before backfilling and final connection is made to the main sewer lines. Any violation of applicable regulations will cause all lines and appurtenances in violation to be removed and replaced at the owners expense.

The Fall Creek Regional Waste District is responsible for the inspection, approval of materials, and installation techniques only. All costs for materials and installation and any liabilities resulting from same is the sole responsibility of the property owner.

I have read and fully understand the above provisions and agree to comply by said provisions.

APPLICANT(S) SIGNATURE


INSPECTOR Tim

Date inspected 8-25-89 Approved ☒ Rejected ☐

Reason for rejection _____

Date reinspected _____ Approved ☐ Rejected ☐

Notes:
Size Pipe 4"
Type Pipe PVC SDR 35
Basement Yes ☐ No ☒
Sump Pump Yes ☐ No ☒
Downspout to Ground Yes ☒ No ☐
Septic Tank Pumped & filled Yes ☒ No ☐
Contractor JERRY COY
Special Conditions NO Septic Tank

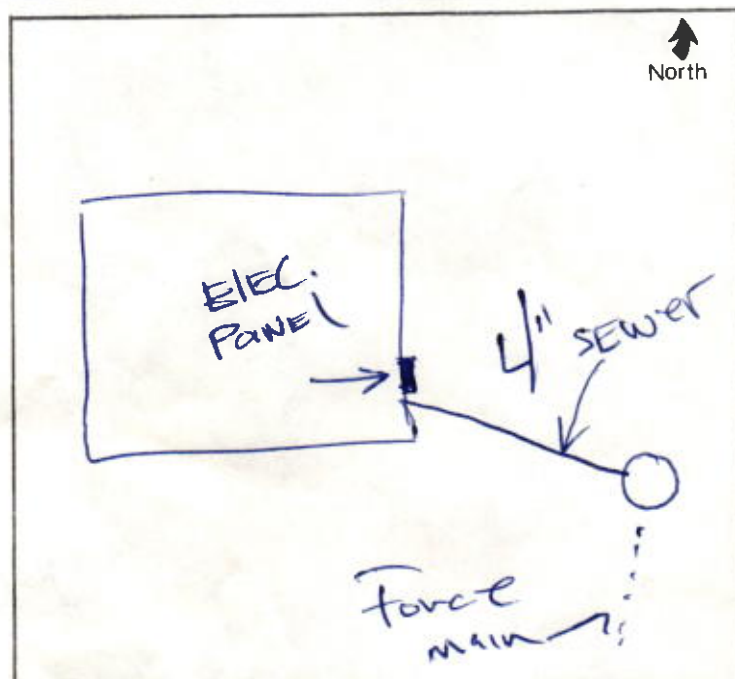



FALL CREEK REGIONAL WASTE DISTRICT
Box 44, Fondulac, Indiana 46064

3-003300000
No 001667

APPLICATION FOR PERMIT

3-20-89

Project Name: Steve Paul
 Property Address: 311 W. N. 2 St
 City: MAHOPA, IN
 Zip: 46048
 Phone: 845-1994
 Owner: Steve Paul
 Engineer: WILL

9249

Application for permit made for connection to the Fall Creek Regional Waste Water Treatment Plant for the above listed property - Permit Type: Domestic, Commercial, Industrial, or Government.


All connections and structures shall conform to the standards of the District Ordinance as amended in volumes 84-1 and 84-2 as amended. All connections and structures shall be made on the District property of the date of this permit. All connections shall be made on the District property of the date of this permit. All connections shall be made on the District property of the date of this permit.

The Fall Creek Regional Waste Water Treatment Plant is responsible for the inspection, maintenance, and operation of the sewerage system. It is the responsibility of the property owner to maintain the sewerage system in good condition and to pay the sewerage fee.

I have read and fully understand the above provisions and agree to comply with them.

Signature: hm
 Date: 8-2-89
 Title: Homeowner
 Name: Steve Paul
 Address: 311 W. N. 2 St
 City: MAHOPA, IN
 Zip: 46048
 Phone: 845-1994

Notes:
 Size Pipe: 4"
 Type Pipe: PVC 20x32
 Basement: Yes
 Sewer Pump: Yes
 Sewerage to Ground: Yes
 Septic Tank: Yes
 Contractor: Jack Col
 Special Conditions: No Septic
 Tank: Jack

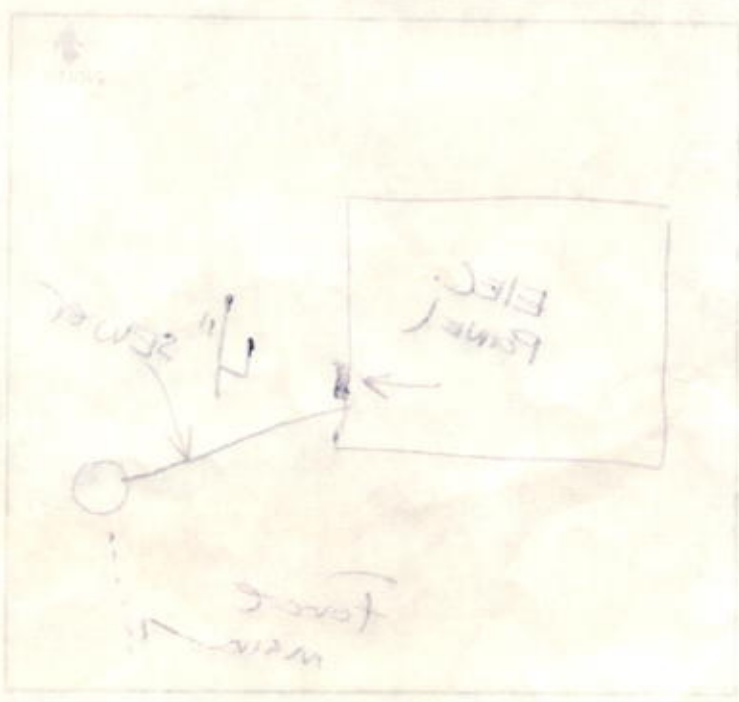

RECEIPT

FALL CREEK REGIONAL WASTE DISTRICT

P.O. BOX 59, CO. RD. 650 WEST

No 2311

Gen. FUNDPENDLETON, IND. 46064, 3-20 19 89RECEIVED FROM Steve Paul \$ 2880.00THE SUM OF Two thousand eight hundred eighty 400/100 DOLLARSON ACCOUNT OF tap fee for
Lot 10 Mahogany EstatesCeresa Sutton

AUTHORIZED SIGNATURE