
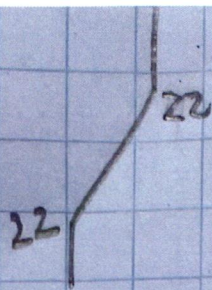


North 

Drawing  
+  
1 picture  
attached






Huntzinger

Lot 63  
5/16/24

273 waters edge Rd.  
Dr Watson

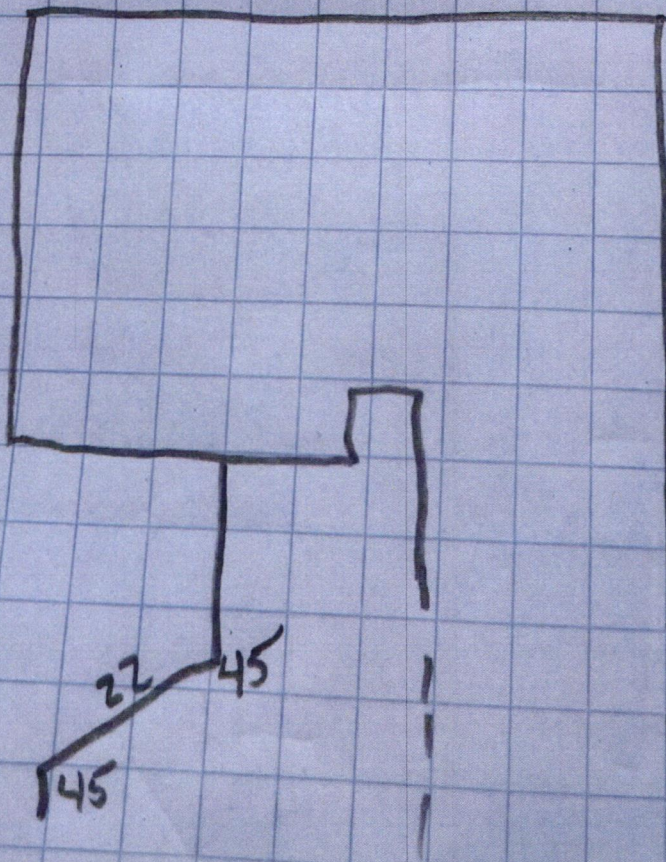

↑  
N







