


26-04720.00


AGREEMENT FOR SANITARY SEWER SERVICE

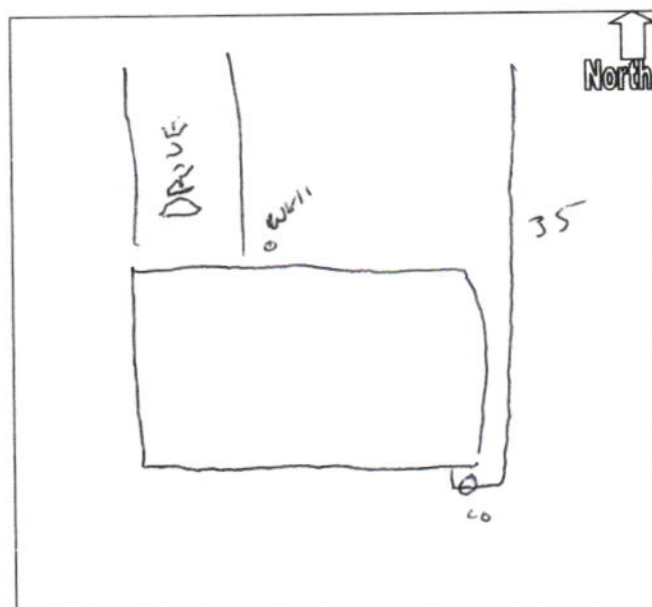

5635

Date April 12, 2001

Pay To The Order Of Fall Creek Regional Waste District \$ 1899⁶⁰

Eighteen hundred ninety-nine — 69/100  Security Features included. Details on Back.

INDEPENDENT FEDERAL CREDIT UNION
ANDERSON, INDIANA 46014

For _____

Marsha A. Mills

2749725791

5635