








Cold Springs Huntzingers

Lot 89 275 Evening Bay Ct.  
4/17/24 Dr. Watson

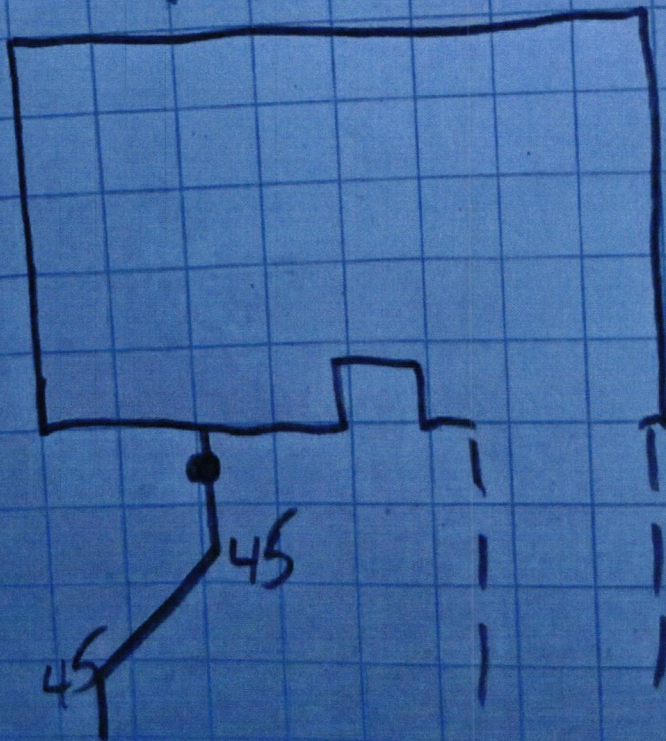

N ↑



shot # 89

Cold Springs

