


4200

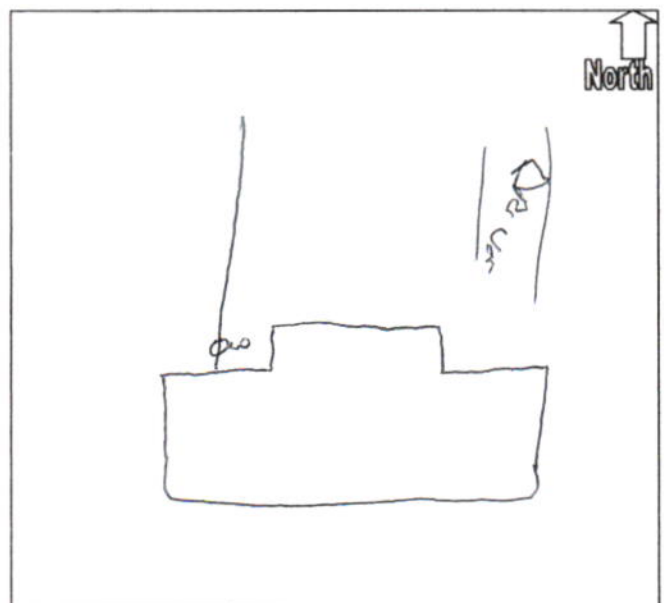

PAMELA K BAUER 3/95
JULIA A OSBORNE, DEBORAH A NUNLEY
2769 WOODLAWN DR PH 778-2661
ANDERSON IN 46013

219

71-7257/2749

3-28-04

Pay to the
Order of

Fall Creek Regional Waste
One Thousand Eight Hundred Ninety Nine ⁶⁰/₁₀₀ \$ 1899.60
Dollars

INDEPENDENT FEDERAL

CREDIT UNION

ANDERSON, INDIANA 46016

For

Pamela K. Bauer

⑆274972579⑆

0219