

8-11-2021

Fall Creek Regional Waste District

#7287

9378 S 650 W, P.O. Box 59, Pendleton, IN 46064

765-778-7544

Agreement for Sanitary Sewer Service

This Agreement made and entered into this 4 day of June, 2021, between Fall Creek Regional Waste District ("District") and D.R. Horton ("Applicant") regarding the provision of sanitary sewer service, and the assignment of capacity in and connection to, the District's facilities for the premises located at Carrick Glen Lot 69.

Street Address: 276 Kimerick Lane

Now therefore, the parties, in consideration of the mutual promises set out in this Agreement, the receipt and sufficiency of which is hereby acknowledged, agree as follows:

1. The Applicant agrees that all workmanship and materials shall conform to all District ordinances and the District's construction standards. District must accept and approve all work and materials before backfilling and final connection is made to the sewer mains. Any violation of this provision will cause all lines and appurtenances in violation to be removed and replaced at the Applicant's expense.
2. The District shall have the right to enter upon the Applicant's premises at all reasonable times to inspect, repair, or replace any equipment used in connection with the District's service or which has an impact on said service.
3. The Applicant shall be responsible for all monthly user rates, capacity charges, and tap fees. The failure to pay any rate charge or fee may result in a lien against the property and/or the termination of service to the property, the cost of which will be borne by Applicant, including, but not limited to, all attorney's fees and collection costs.
4. The District shall not be responsible for any damages as a result of any failure to supply service unless said damages are due to default, neglect or culpability on the part of the District.
5. If there is an available sanitary sewer within three hundred (300) feet of the property line, the property owner shall be required to connect to the District's sanitary sewer system.
6. The Applicant and District agree that the provision of sanitary sewer service touches and concerns the property and the terms of this Agreement bind the District and Applicant and their heirs, executors, administrators, personal representatives, successors, agents, attorneys, assigns, designees, and transferees.

The parties hereto have read and fully understand the above provisions and agree to comply with said provisions.

FALL CREEK REGIONAL WASTE DISTRICT

Signature

APPLICANT


Signature

STATE OF INDIANA )

) SS:

COUNTY OF MADISON )

SUBSCRIBED and sworn to before me this 4 day of June, 2021

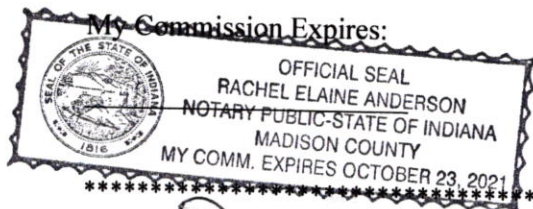

Signature

Printed

Notary Public

Resident of Madison County

Inspector Dor

Date Inspected 9-2-21

Approved ☒

Rejected ☐

Reason for Rejection

Date Reinspected

Approved ☐

Rejected ☐

Notes:

Size Pipe 6"

Type Pipe PVC 35

Basement Yes ☐ No ☐

Sump Pump Yes ☐ No ☐

Downspout to Ground Yes ☐ No ☐

Septic Tank Pumped & Filled Yes ☐ No ☐

Contractor

Special Conditions

Existing Home ☒

New Construction ☐

North

Drawing  
+  
2 pictures  
attached






# STOEPPELWERTH

ALWAYS ON

7965 East 106th Street, Fishers, IN 46038-2505  
phone: 317.849.5935 fax: 317.849.5942

(PIN)

THE FOOTINGS FOR THIS HOUSE SHOULD BE PINNED SINCE THERE IS LITTLE OR NO TOLERANCE ON THE SIDE YARD REQUIREMENT. CALL US WHEN FOOTING IS IN SO WE CAN SCHEDULE PINNING.

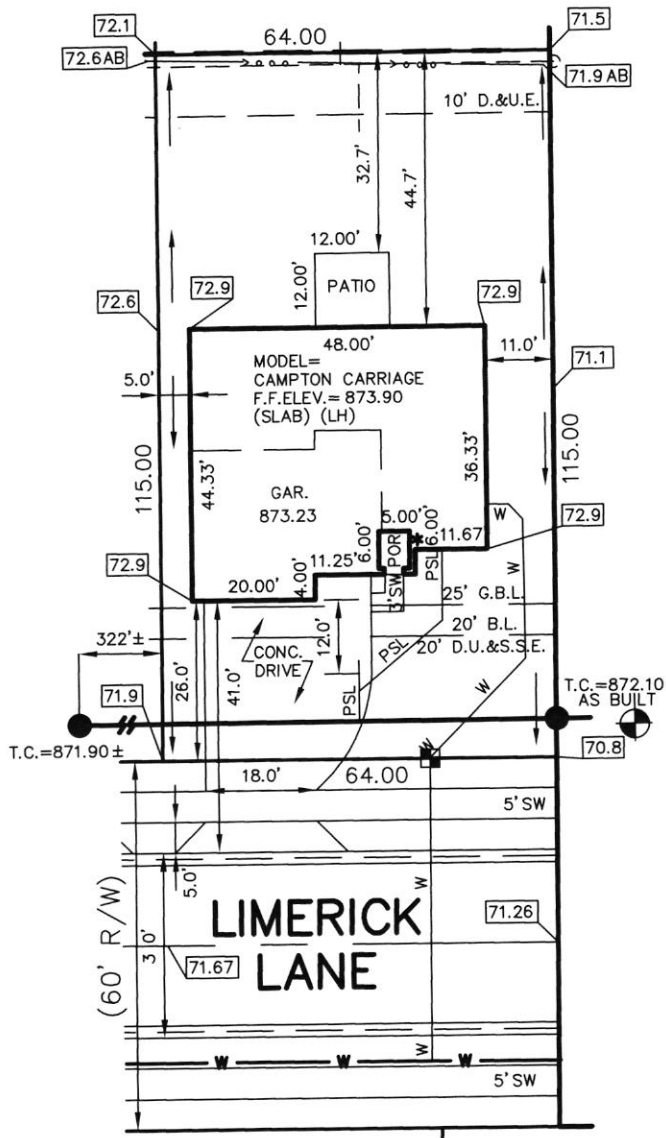

JOB ID CARG2.69

CONTROL# 97793 DRH

276 LIMERICK LANE  
PENDLETON, IN 46064


1" = 30'

LOT AREA: 7,360 Sq. Ft.

LOT COVERAGE=35.8%  
M.L.A.G.=872.5  
M.F.F.=873.0

- LEGEND:
- XX.X PROPOSED GRADE PER PLAN
  - XX.XAB AS BUILT GRADE
  - S.S.D. SUB-SURFACE DRAIN
  - ASL SANITARY SEWER
  - PSL 6" AS BUILT SANITARY LATERAL
  - PSL 6" PROPOSED SANITARY LATERAL
  - W STORM SEWER
  - W 3/4" WATER CONNECTION
  - W WATER MAIN
  - SW SWALE
  - SANITARY MANHOLE
  - STORM MANHOLE
  - CURB INLET
  - ⚡ FIRE HYDRANT
  - ⊠ WATER METER
  - D.U.&S.S.E. DRAINAGE, UTILITY & SANITARY SEWER EASEMENT
  - D.&U.E. DRAINAGE & UTILITY EASEMENT
  - B.L. BUILDING LINE
  - G.B.L. GARGE BUILDING LINE
  - M.L.A.G. MINIMUM LOWEST ADJACENT GRADE
  - M.F.F. MINIMUM FINISHED FLOOR

CONTRACTOR SHALL CUT 5' OFF OF LATERAL AND BEGIN FROM THAT POINT AND CONNECT TO HOUSE FOLLOWING PLOT PLAN.

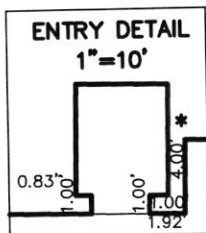

LOT 69  
CARRICK GLEN  
SECTION 2

INST. #2021R000943

ZONING: SINGLE FAMILY

5' MINIMUM SIDE YARD

15' MINIMUM REAR YARD

50% MAXIMUM LOT COVERAGE

BENCHMARK  
TOP OF CASTING=872.10

ALL UNDERGROUND SEWERS AND UTILITIES SHOWN ARE PLOTTED BY SCALE FROM DESIGN PLANS FURNISHED BY ENGINEER. THE ACTUAL FIELD LOCATION MAY VARY.

SOD: 1,590 ± Sq. Ft.  
SEEDING: 3,336 ± Sq. Ft.  
CONC. DRIVEWAY: 1,026 ± Sq. Ft.  
PRIVATE WALK: 25 ± Sq. Ft.  
PUBLIC WALK: 230 ± Sq. Ft.




David J. Stoeppelwerth

NOTE: THIS DRAWING IS NOT INTENDED TO BE REPRESENTED AS A RETRACEMENT OR ORIGINAL BOUNDARY SURVEY, A ROUTE SURVEY OR A SURVEYOR LOCATION REPORT.

04/21/21 JRS





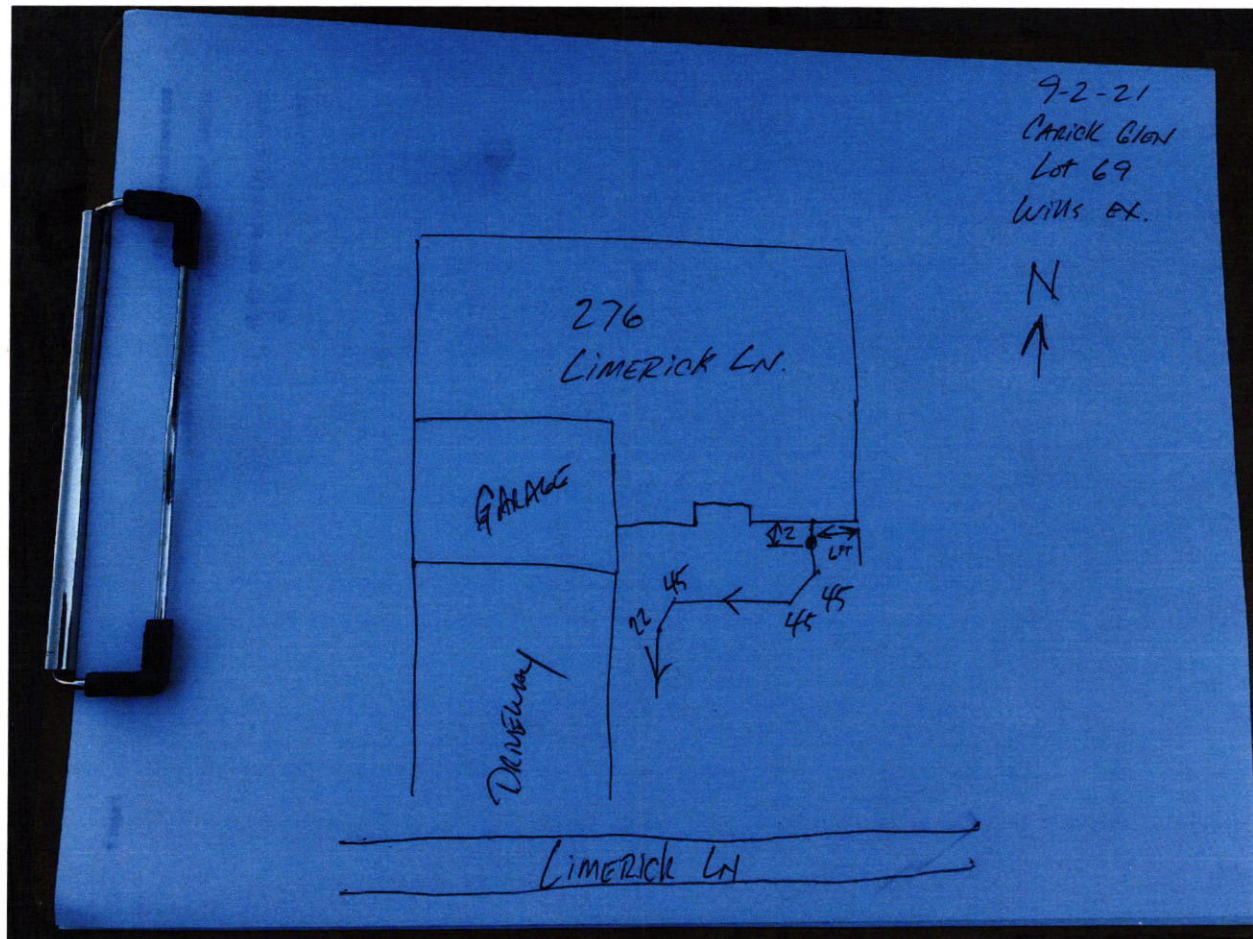









**D.R. HORTON**  
America's BuilderJP Morgan Chase Bank, N.A.  
Syracuse, NY**Check Number 1277708****DRH Inc. Controlled Dish**  
1341 Horton Circle  
Arlington, TX 76011

50-937

213

2720128

| Date     | Amount        |
|----------|---------------|
| 04/07/21 | \$*****760.00 |

Void after 6 months from date of issue

**SEVEN HUNDRED SIXTY AND 00/100 \*\*\*\*\***Pay To The Order Of:  
FALL CREEK REGIONAL WASTE DISTRICT  
9378 SOUTH 650 WEST  
PENDLETON IN 46064D. L. Horton

Rec # 01730