


North 

Drawing
+
1 picture
attached




7965 East 106th Street, Fishers, IN 46038-2505
phone: 317.849.5935 fax: 317.849.5942

CONTROL# 98261 DRH


277 MILLTOWN DRIVE
PENDLETON, IN 46064

LOT AREA: 10,124 Sq. Ft.

LOT COVERAGE=25.6%
M.L.A.G.=872.3
M.F.F.=872.9

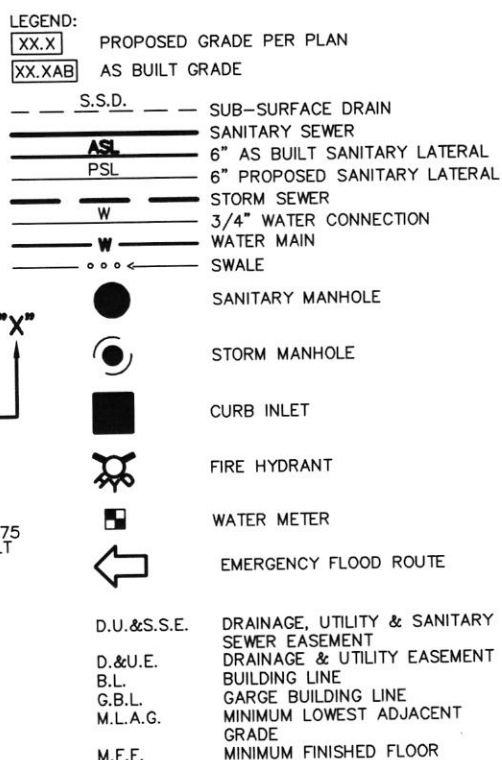

* NOTE: HANDICAP RAMP IS IN DRIVE.

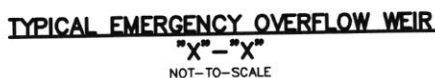

TOP OF CASTING=870.88

ALL UNDERGROUND SEWERS AND UTILITIES
SHOWN ARE PLOTTED BY SCALE FROM
"RECORD DRAWINGS" FURNISHED BY ENGINEER.

LOT 98
CARRICK GLEN
SECTION 2

INST. #2021R000943

ZONING: SINGLE FAMILY

5' MINIMUM SIDE YARD

15' MINIMUM REAR YARD



50% MAXIMUM LOT COVERAGE

SOD:	2,496 ±	Sq. Ft.
SEEDING:	5,365 ±	Sq. Ft.
CONC. DRIVEWAY:	1,008 ±	Sq. Ft.
PRIVATE WALK:	54 ±	Sq. Ft.
PUBLIC WALK:	328 ±	Sq. Ft.

05/18/21 JSS



Carrick Glen
Lot 98 277 Milltown Dr.
10/5/21 WILLS of

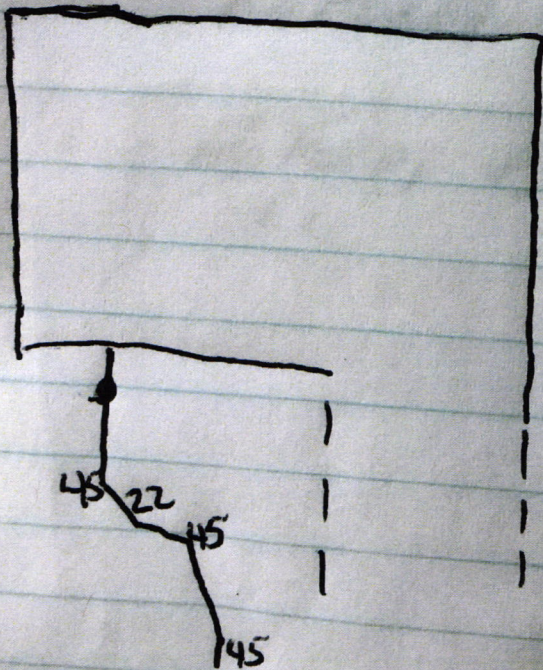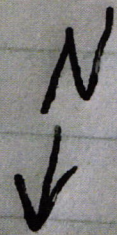



D.R. HORTON
America's Builder**DRH Inc. Controlled Disb**
1341 Horton Circle
Arlington, TX 76011JP Morgan Chase Bank, N.A.
Syracuse, NY**Check Number 1299161**50-937
213

2720128

Date	Amount
05/17/21	\$*****760.00

Void after 6 months from date of issue

SEVEN HUNDRED SIXTY AND 00/100 *****Pay To The Order Of:
FALL CREEK REGIONAL WASTE DISTRICT
9378 SOUTH 650 WEST
PENDLETON IN 46064D. L. Horton

Rec # 011734