Fall Creek Regional Waste District 9378 S 650 W, P.O. Box 59, Pendleton, IN 46064 765-778-7544

Agreement for Sanitary Sewer Service

#	7	2	n	1
#	1	J	U	4

This Agreement made and entered into this day of da					
Street Address: 378 Milltown Dr					
Now therefore, the parties, in consideration of the mutual preceipt and sufficiency of which is hereby acknowledged, agree	promises set out in this Agreement, the as follows:				
 The Applicant agrees that all workmanship and materials shall conform to all District ordinances and the District's construction standards. District must accept and approve all work and materials before backfilling and final connection is made to the sewer mains. Any violation of this provision will cause all lines and appurtenances in violation to be removed and replaced at the Applicant's expense. The District shall have the right to enter upon the Applicant's premises at all reasonable times to inspect, repair, or replace any equipment used in connection with the District's service or which has an impact on said service. The Applicant shall be responsible for all monthly user rates, capacity charges, and tap fees. The failure to pay any rate charge or fee may result in a lien against the property and/or the termination of service to the property, the cost of which will be borne by Applicant, including, but not limited to, all attorney's fees and collection costs. The District shall not be responsible for any damages as a result of any failure to supply service unless said damages are due to default, neglect or culpability on the part of the District. If there is an available sanitary sewer within three hundred (300) feet of the property line, the property owner shall be required to connect to the District's sanitary sewer system. The Applicant and District agree that the provision of sanitary sewer service touches and concerns the property and the terms of this Agreement bind the District and Applicant and their heirs, executors, administrators, personal representatives, successors, agents, attorneys, assigns, designees, and transferees. 					
The parties hereto have read and fully understand the above provisions and agree to comply with said provisions. FALL CREEK REGIONAL WASTE DISTRICT APPLICANT					
Signature Signature	Signature				
STATE OF INDIANA) SS: COUNTY OF MADISON)					
SUBSCRIBED and sworn to before me this 10 day of 101, 201					
Signature Rachel Edine Anderson NOTARY PUBLIC-STATE OF INDIANA MADISON COUNTY MY COMM. EXPIRES OCTOBER 23, 2021 Notary Public Notary Public					
	sident of <u>Median</u> County				
Inspector Dav Date Inspected 10-1-21 Approved Rejected Rejected					
Reason for Rejecton Approved	Rejected				
Notes: /4					
Size Pipe Type Pipe Pipe 38 Basement Yes No	No. at 1				
Sump Pump Yes No North					
Downspout to Ground <u>Yes No</u> Septic Tank Pumped & Filled Yes No					
Contractor WINS EX	Drawing				
Special Conditions	_				
Existing Home New Construction	Τ				
New Construction	2 pictures attached				

NOTATIV

STOE<u>PPELW</u>ERTH

ALWAYS ON

7965 East 106th Street, Fishers, IN 46038-2505 phone: 317.849.5935 fax: 317.849.5942

72.7

72.9

115.00

73.2

13.2

73.2

≱ 20' G.B.L

15' B.L.

MILLTOWN

335'±

64.00

15′ D.&U.E

72.1

5' SW

46.33

JOB ID CARG2.86

CONTROL# 97481 DRH

278 MILLTOWN DRIVE PENDLETON, IN 46064



1'' = 30'LOT AREA: 7,360 Sq. Ft.

M.L.A.G.=872.3 M.F.F.=873.0

LEGEND:

XX.X

PROPOSED GRADE PER PLAN

XX.XAB

AS BUILT GRADE

S.S.D. SUB-SURFACE DRAIN
SANITARY SEWER
6" AS BUILT SANITARY LATERAL
6" PROPOSED SANITARY LATERAL
STORM SEWER
W 3/4" WATER CONNECTION
WATER MAIN
SWALE
SANITARY MANHOLE

STORM MANHOLE

CURB INLET

FIRE HYDRANT

■ WATER METER

D.&U.E. DRAINAGE & UTILITY EASEMENT
B.L. BUILDING LINE
G.B.L. GARGE BUILDING LINE
M.L.A.G. MINIMUM LOWEST ADJACENT
GRADE
M.F.F. MINIMUM FINISHED FLOOR

CONTRACTOR SHALL CUT 5.5' OFF OF LATERAL AND BEGIN FROM THAT POINT AND CONNECT TO HOUSE FOLLOWING PLOT PLAN.

No. 80040474
STATE OF WOIANA SURVEY

NOTE: THIS DRAWING IS NOT INTENDED TO BE REPRESENTED AS A RETRACEMENT OR ORIGINAL BOUNDARY SURVEY, A ROUTE SURVEY OR A SURVEYOR LOCATION REPORT.

LOT 86 CARRICK GLEN SECTION 2

72.2

72.6

00

115

SOD

71.8

R

60,

64.00

12.00'

40.00

MODEL= LAFAYETTE CRAFTSMAN F.F.ELEV.= 874.20 (SLAB) (LH)

POR

PATIO

GAR

873.53

CONC

71.63

39.7

73.2

10.8

10' D.&U.E.

INST. #2021R000943
ZONING: SINGLE FAMILY
5' MINIMUM SIDE YARD
15' MINIMUM REAR YARD
50% MAXIMUM LOT COVERAGE

BENCHMARK

TOP OF CURB = 871.90

ALL UNDERGROUND SEWERS AND UTILITIES SHOWN ARE PLOTTED BY SCALE FROM DESIGN PLANS FURNISHED BY ENGINEER THE ACTUAL FIELD LOCATION MAY VARY.


T.C.=871.90 ±

SOD: $3,593 \pm 3q$. Ft. $3,593 \pm 3q$. Ft. $3,593 \pm 3q$. Ft. $673 \pm 3q$. Ft. $673 \pm 3q$. Ft. 9. Ft.

04/08/21 JRS

Know what's below.

Call before you die

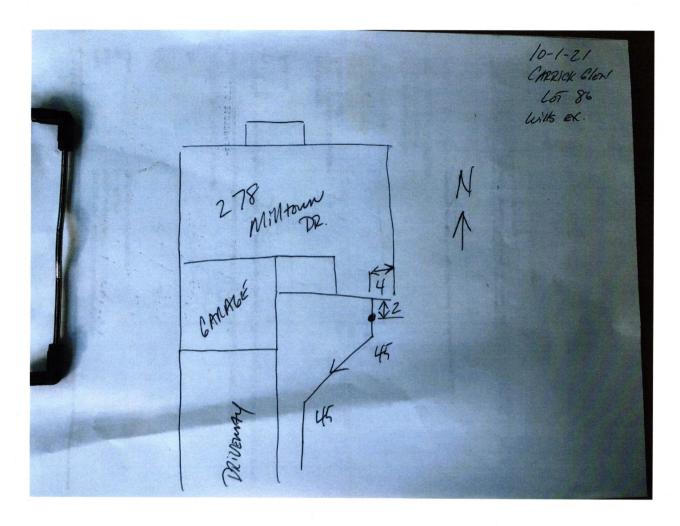





THIS CHECK IS PRINTED IN RED AND BLUE INK ON THE FACE ON CHEMICAL AND BLEACH REACTIVE PAPER WITH INVISIBLE FLUORESCENT FIBERS AND BASKETWEAVE ON BACK DRHORTON Builder Check Number JP Morgan Chase Bank, N.A.

Syracuse, NY

50-937 213

Date Amount \$*****760.00 03/31/21

1274586

2720128

Void after 6 months from date of issue

SEVEN HUNDRED SIXTY AND 00/100 ************

DRH Inc. Controlled Disb

1341 Horton Circle

Arlington, TX 76011

Pay To The Order Of: FALL CREEK REGIONAL WASTE DISTRICT 9378 SOUTH 650 WEST PENDLETON IN 46064

flec# Ollelele