
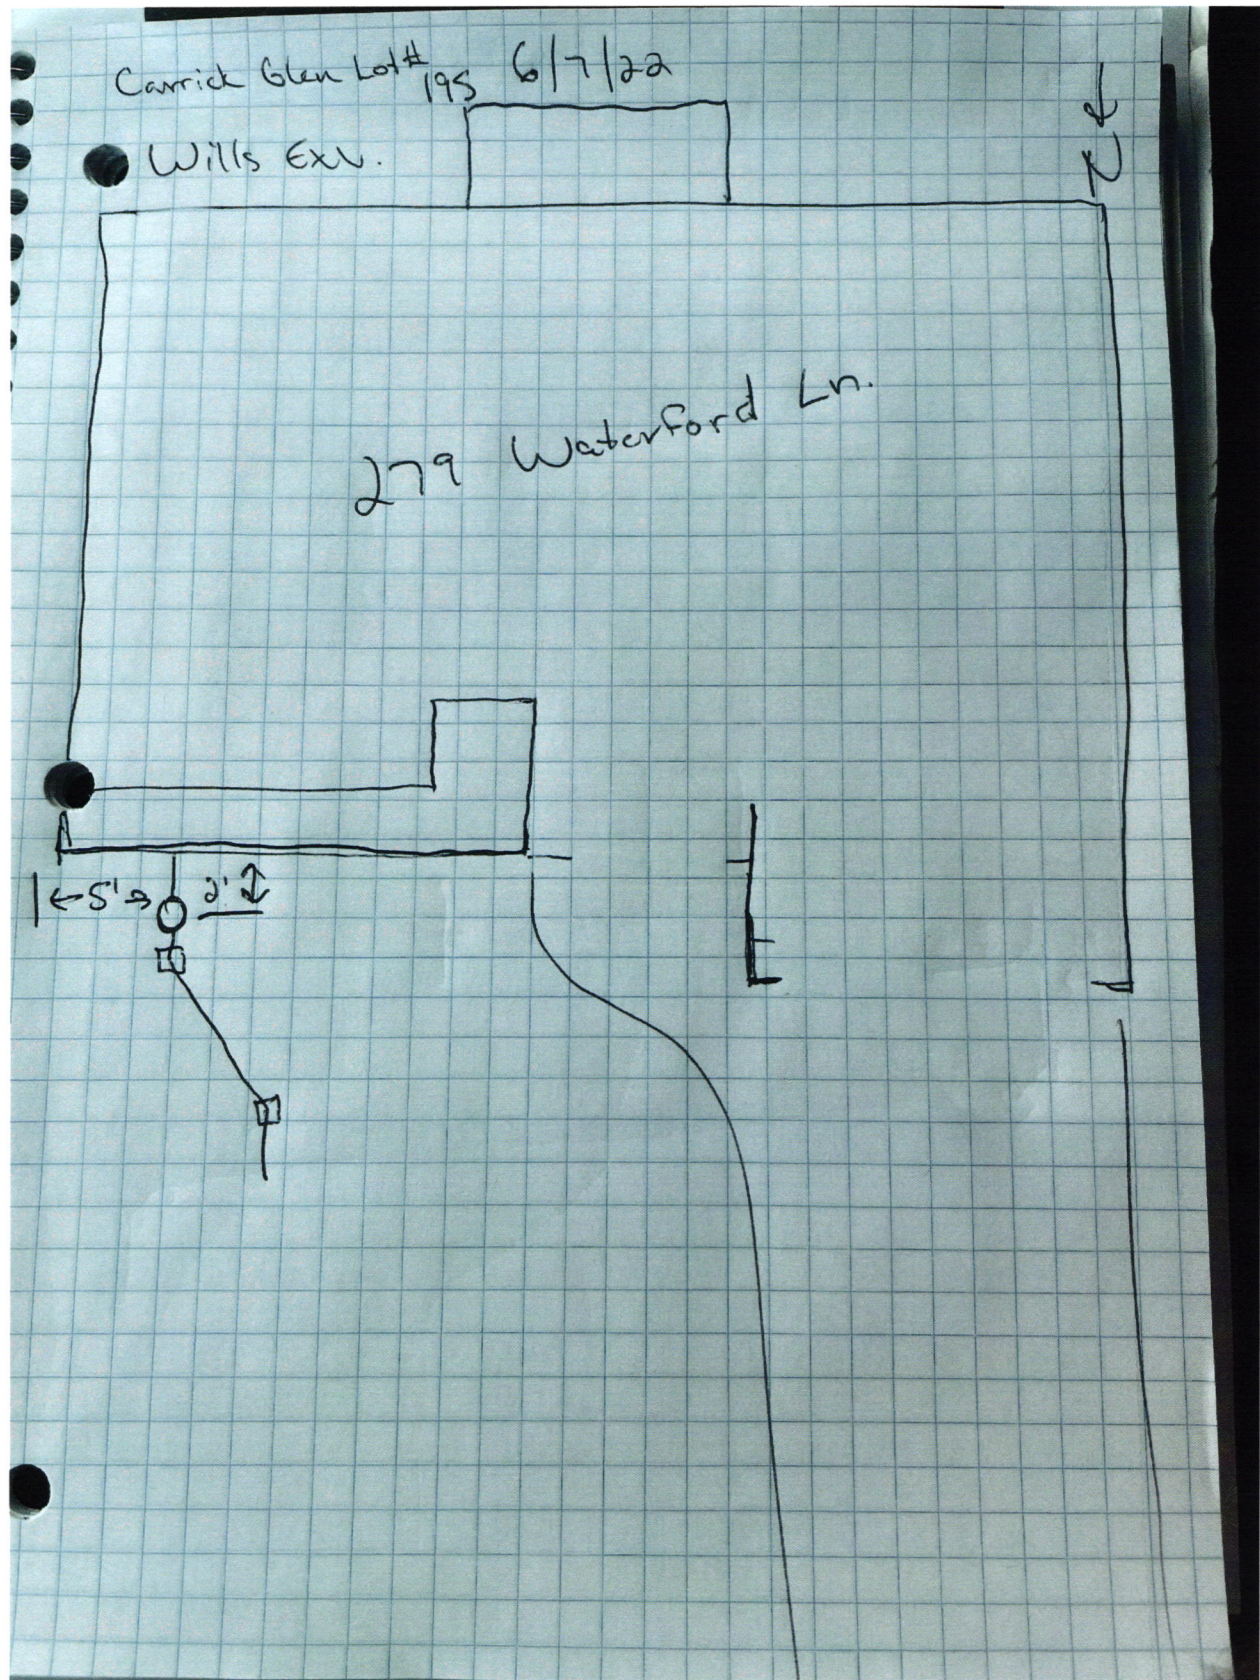


North 

Drawing
+
1 picture
attached





D. L. HORTON
America's BuilderJP Morgan Chase Bank, N.A.
Syracuse, NY

Check Number 1420847

DRH Inc. Controlled Disb
1341 Horton Circle
Arlington, TX 76011

50-937

213

2720128

Date	Amount
12/22/21	\$*****760.00

Void after 6 months from date of issue

SEVEN HUNDRED SIXTY AND 00/100 *****

Pay To The Order Of:
FALL CREEK REGIONAL WASTE DISTRICT
9378 SOUTH 650 WEST
PENDLETON IN 46064D. L. Horton

CG 195

012021