



FALL CREEK REGIONAL WASTE DISTRICT

9378 S. 650 West PO Box 59
Pendleton, IN 46064-0059 778-7544

No 2972

APPLICATION FOR SEWER PERMIT

Date 12/1/00

Permit Void 90 days from Date of Issuance

Owner Name SCOTT JULIE BELLINE

Property Address 27 W. US HWY 36

Lot # _____ P.O. Box _____

Town PENDLETON, IN Zip Code 46004

Phone (765) 778-2799 City Water _____ Well ☒

\$ 2556.00 Tap on Fee Paid

\$ _____ ~~Inspection fee paid~~

Application is hereby made for connection to the Fall Creek Regional Waste District Sewer System for the above listed property - Permit Type: Residential ☒, Commercial _____, Industrial _____, or Governmental/Institutional _____. User Information _____.

All workmanship and materials shall conform to the standards of the District Ordinance as described in Ordinance 84-2 and 84-3 as amended. Acceptance and approval must be made by the District inspector or his duly authorized representative before backfilling and final connection is made to the main sewer lines. Any violation of applicable regulations will cause all lines and appurtenances in violation to be removed and replaced at the owners expense.

The Fall Creek Regional Waste District is responsible for the inspection, approval of materials, and installation techniques only. All costs for materials and installation and any liabilities resulting from same is the sole responsibility of the property owner.

I have read and fully understand the above provisions and agree to comply by said provisions.

[Signature]
APPLICANT(S) SIGNATURE

INSPECTOR B


Date inspected 6-14-02 Approved ☒ Rejected _____

Reason for rejection _____

Date reinspected _____ Approved _____ Rejected _____

Notes:
Size Pipe 4" - 12"
Type Pipe POC
Basement Yes ☒ No _____
Sump Pump Yes _____ No ☒
Downspout to Ground Yes ☒ No _____
Septic Tank Pumped & filled Yes _____ No ☒
Contractor Royal Flush/FREDRICK
Special Conditions _____

Existing Home _____
New Construction ☒
BARN CONVERSION

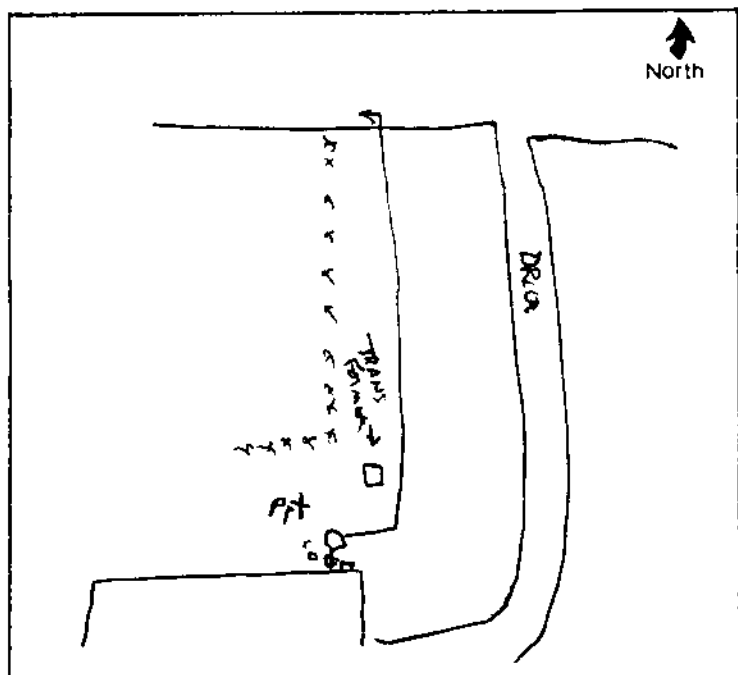

JAMES SCOTT BERLINE 01/01
JULIE A. BERLINE
226 S WEST ST
PENDLETON, IN 46064

1123

20-67740 308

12/17/01

DATE

PAY TO
THE ORDER OF FCWD

\$ 2556.00

TWO THOUSAND FIVE HUNDRED FORTY SIX

00/100

DOLLARS



Security
Features
Details on
Back

National City.

National City Bank of Indiana
Anderson, Indiana

FOR TAP FEES

⑆074000065⑆

1123

[Signature]

JAMES SCOTT BERLINE 01/01
JULIE A. BERLINE
226 S WEST ST
PENDLETON, IN 48064

1153

20-6/740 308

11/21/02

DATE

PAY TO
THE ORDER OF FRIEND

\$ 1024.80

ONE THOUSAND AND TWENTY FOUR

8/100

DOLLARS



Security
Features
Optional
or
None

National City.

National City Bank of Indiana
Anderson, Indiana

FOR GRANDPARENTS

10740000651

1153