


Huntzinger

Lat 45 282 Cold Springs Pt.
5/16/24 Pt. Watson



← N

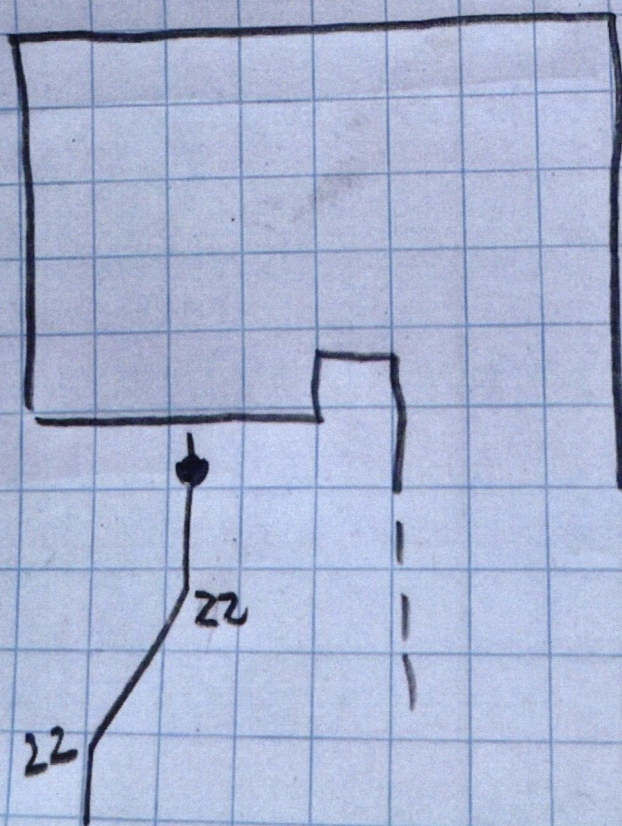