#7282

Fall Creek Regional Waste District 9378 S 650 W, P.O. Box 59, Pendleton, IN 46064 765-778-7544

Agreement for Sanitary Sewer Service

This Agreement made and entered into thisday of \(\frac{1}{2} \) Regional Waste District ("District") andD.R. Horton	
provision of sanitary sewer service, and the assignment of capa	
facilities for the premises located at Carrick Glen Lot 64	
Street Address: 283 35 Carrich G	len Blud
Now therefore, the parties, in consideration of the mutual receipt and sufficiency of which is hereby acknowledged, agree	promises set out in this Agreement, the e as follows:
 The Applicant agrees that all workmanship and materia and the District's construction standards. District must before backfilling and final connection is made to the s provision will cause all lines and appurtenances in viola Applicant's expense. 	accept and approve all work and materials ewer mains. Any violation of this
The District shall have the right to enter upon the Appl inspect, repair, or replace any equipment used in conne has an impact on said service.	icant's premises at all reasonable times to ction with the District's service or which
 The Applicant shall be responsible for all monthly user failure to pay any rate charge or fee may result in a lien termination of service to the property, the cost of which 	against the property and/or the will be borne by Applicant, including,
but not limited to, all attorney's fees and collection cos4. The District shall not be responsible for any damages a unless said damages are due to default, neglect or culpa	s a result of any failure to supply service
If there is an available sanitary sewer within three hund	lred (300) feet of the property line, the
property owner shall be required to connect to the District. 6. The Applicant and District agree that the provision of s	
concerns the property and the terms of this Agreement	bind the District and Applicant and their
heirs, executors, administrators, personal representative designees, and transferees.	es, successors, agents, attorneys, assigns,
The parties hereto have read and fully understand the above provisions.	e provisions and agree to comply with said
FALL CREEK REGIONAL WASTE DISTRICT	APPLICANT
Signature Signature	Signature
STATE OF INDIANA)	
) SS: COUNTY OF MADISON)	
SUBSCRIBED and sworn to before me this 5 day of 1	pril , 20 <u>21</u>
My Commission Expires: OFFICIAL SEAL REBECCA LYNN HUNTER NOTARY PUBLIC-STATE OF INDIANA HAMILTON COUNTY MY COMM. EXPIRES NOV 19, 2023 Re	Beleace of ymmoderater Deced Lynn Horter Distance Public Desident of Harmitan County
Inspector 5N Date Inspected 7/12 2 Approved Reason for Rejecton	Rejected
Date Reinspected Approved	Rejected
Notes: Size Pipe 611 Type Pipe 35	-
Basement Yes No	North
Sump Pump <u>Yes No</u> Downspout to Ground Yes No	
Septic Tank Pumped & Filled Yes No	Drawin
Contractor wills w	5. 4.5.
Special Conditions Existing Home	
New Construction	1 Picture
	attached

STOEPPELWERTH

64.00

42.7

12.00'

PATIO

MODEL= 48.00'
CAMPTON CRAFTSMAN
F.F.ELEV.= 876.00
(SLAB) (RH)

00

75.0

75.0

G.B.L. PSL

20 B.L.

64.00

74.02

T.C.=874.70

5'SW

8 10.6

25.

SOD

15' D.&U.E

R/W)

74.2

74.5

54.7

75.0

44.33

GAR

874.33

41.0

18.0

74.21

74.31

(60

R /W)B.O 290'±

10' D.&U.E.

71.5

7965 East 106th Street, Fishers, IN 46038-2505 phone: 317.849.5935 fax: 317.849.5942

72.1

25.

75.0 SOF

74.5

CARRICK GLEN

BOULEVARD

JOB ID CARG2.64

CONTROL# 97108 DRH

321 CARRICK GLEN BOULEVARD PENDLETON, IN 46064



1" = 30'LOT AREA: 8,000 Sq. Ft.

LOT COVERAGE=33.2%

M.L.A.G.=872.4 M.F.F.=875.4

LEGEND: XX.X XX.XAB

PROPOSED GRADE PER PLAN

AS BUILT GRADE

S.S.D. — — SUB-SURFACE DRAIN PSL W W

SANITARY SEWER
6" AS BUILT SANITARY LATERAL
6" PROPOSED SANITARY LATERAL STORM SEWER 3/4" WATER CONNECTION
WATER MAIN

SWALE

SANITARY MANHOLE

6

STORM MANHOLE

CURB INLET FIRE HYDRANT

WATER METER

B.O.

BLOW OFF

 $\stackrel{\mathbf{w}}{\boxtimes}$

WATER VALVE


D.&U.E. G.B.L. M.L.A.G.

M.F.F.

DRAINAGE & UTILITY EASEMENT BUILDING LINE GARGE BUILDING LINE MINIMUM LOWEST ADJACENT

MINIMUM LOWEST GRADE
GRADE
MINIMUM FINISHED FLOOR

CONTRACTOR SHALL CUT 8' OFF OF LATERAL AND BEGIN FROM THAT POINT AND CONNECT TO HOUSE FOLLOWING PLOT PLAN.

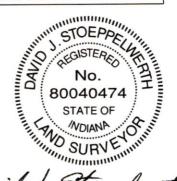

ALL UNDERGROUND SEWERS AND UTILITIES SHOWN ARE PLOTTED BY SCALE FROM DESIGN PLANS FURNISHED BY ENGINEER THE ACTUAL FIELD LOCATION MAY VARY.


1,513 ± Sq. Ft. 3,979 ± Sq. Ft. SOD: SEEDING: CONC. DRIVEWAY: 1,028 ± Sq. Ft. PRIVATE WALK: 25 ± Sq. Ft. PUBLIC WALK: 255 ± Sq. Ft.


LOT 64 CARRICK GLEN SECTION

INST. #2021R000943 ZONING: SINGLE FAMILY 5' MINIMUM SIDE YARD 15' MINIMUM REAR YARD 50% MAXIMUM LOT COVERAGE

BENCHMARK TOP OF CURB = 874.31

03/18/21 NSH

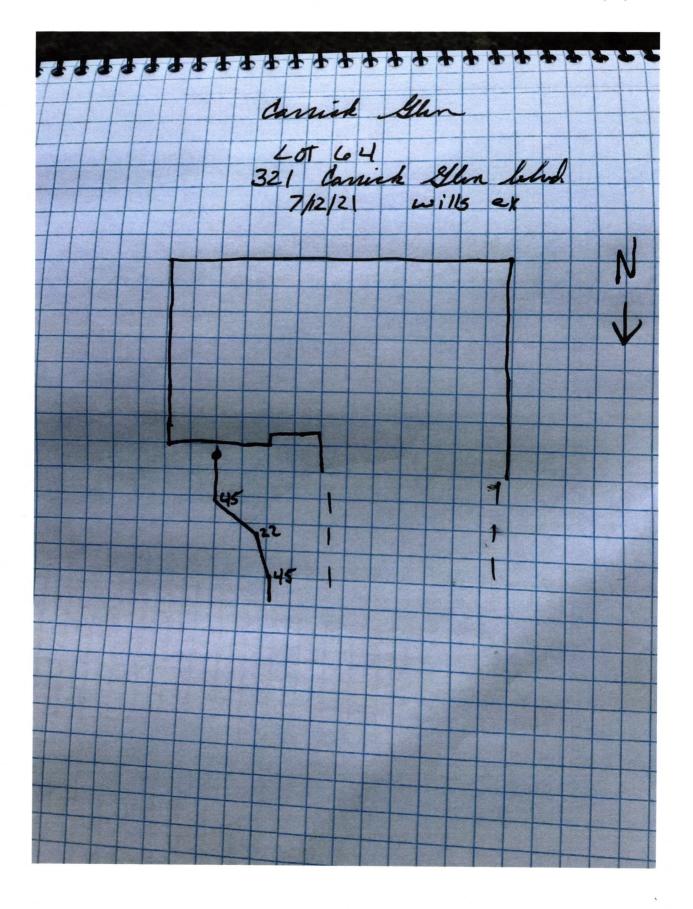

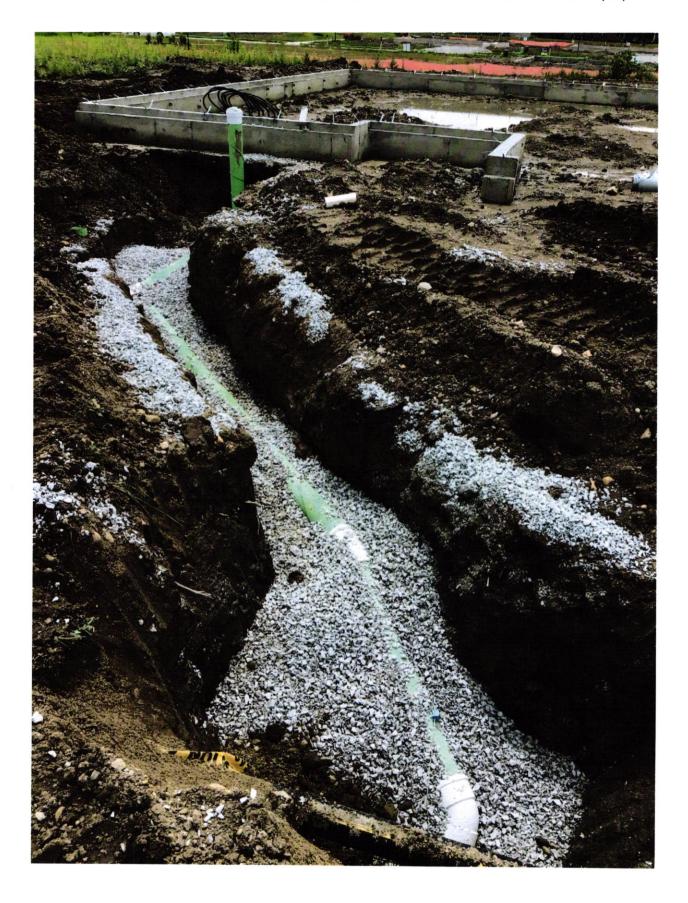

Check Number

1264862

Date

03/15/21

FALL CREEK REGIONAL WASTE DISTRICT

937, SOUTH 650 WEST

H Inc. Controlled Disb		Stub 1 of 1			2720128
PO Numb Invoice Number Subdv	Lot# Lot Addr	ress Cost Cde Legal Desc	Gross	Deductions	Amount Paid
CG64SEWER 55516	0064 0064 TBD		760.00		760.00
			760.00		760.00

THIS CHECK IS PRINTED IN RED AND BLUE INK ON THE FACE ON CHEMICAL AND BLEACH REACTIVE PAPER WITH INVISIBLE FLUORESCENT FIBERS AND BASKETWEAVE ON BACK

DAHORTON America's Builder

JP Morgan Chase Bank, N.A. Syracuse, NY

Check Number

1264862

DRH Inc. Controlled Disb 1341 Horton Circle Arlington, TX 76011

50-937 213

2720128

Date Amount \$******760.00 03/15/21 Void after 6 months from date of issue

Pay To The Order Of: FALL CREEK REGIONAL WASTE DISTRICT 9378 SOUTH 650 WEST PENDLETON IN 46064