

add order
on file

4105

26-04230.00

This Agreement made and entered into this 12 day of March, 2001, between FALL CREEK REGIONAL WASTE DISTRICT ("District") and Jack Davis ("Applicant") regarding the provision of sanitary sewer service, and the assignment of capacity in, and connection to, the District's facilities for the premises located at 2873 Ridge Lane.

1. The Applicant agrees that all workmanship and materials shall conform to all District ordinances and the District's construction standards. District must accept and approve all work and materials before backfilling and final connection is made to the sewer mains. Any violation of this provision will cause all lines and appurtenances in violation to be removed and replaced at the Applicant's expense.

3. The Applicant shall be responsible for all monthly user rates, capacity charges, and tap fees. The failure to pay any rate charge or fee may result in a lien against the property and/or the termination of service to the property, the cost of which will be borne by Applicant, including, but not limited to, all attorney's fees and collection costs.

5. If there is an available sanitary sewer within three hundred (300) feet of the property line, the property owner shall be required to connect to the District's sanitary sewer system.

The parties hereto have read and fully understand the above provisions and agree to comply with said provisions.

APPLICANT Jack J. Davis
Signature

SUBSCRIBED and sworn to before me this 12TH day of MARCH, 2001.

Signature [Signature]

Printed JERRY D. KELLY
Notary Public
Resident of Madison County

INSPECTOR B DATE INSPECTED 3-14-01 APPROVED ✓ REJECTED _____

REASON FOR REJECTION _____

DATE REINSPECTED _____ APPROVED _____ REJECTED _____

NOTES: SIZE PIPE 6" TYPE PIPE 35

BASEMENT YES NO ☒

SUMP PUMP YES NO ☒

DOWNSPOUT TO GROUND YES X NO _____


SEPTIC TANK PUMPED & FILLED YES X NO

CONTRACTOR Dietz

SPECIAL CONDITIONS

EXISTING HOME ☒

NEW CONSTRUCTION

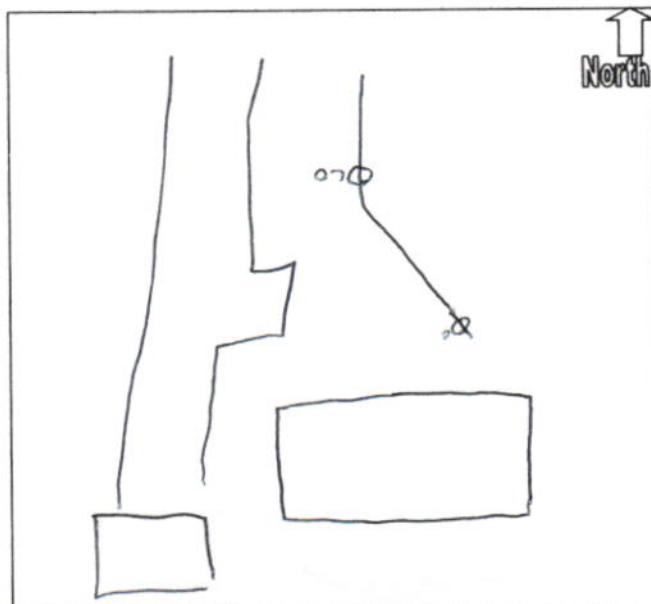

Jack J. Davis 08/00
Deborah L. Davis
2873 W Ridge Ln Ph 765-778-0388
Anderson, In 46013

0327

3-12-01

20-6/740 308

DATE

PAY TO
THE ORDER OF

FCRWD

\$2,036.35

Two Thousand Thirty Six dollars +35/100

DOLLARS



Security
Features
Details
Back

National City.

National City Bank of Indiana
Anderson, Indiana

FOR

Jack J. Davis

0327

⑆074000065⑆

© HARLAND
METROPOLITAN