

FALL CREEK REGIONAL WASTE DISTRICT

9378 S 650 WEST, P.O. BOX 59, PENDLETON, IN 46064

765-778-7544

AGREEMENT FOR SANITARY SEWER SERVICE

4233

26-02820.00

add order
on file

This Agreement made and entered into this 6th day of April, 2001, between FALL CREEK REGIONAL WASTE DISTRICT ("District") and Melanie Swinford ("Applicant") regarding the provision of sanitary sewer service, and the assignment of capacity in, and connection to, the District's facilities for the premises located at 2883 Helter Court.

NOW THEREFORE, the parties, in consideration of the mutual promises set out in this Agreement, the receipt and sufficiency of which is hereby acknowledged, agree as follows:

1. The Applicant agrees that all workmanship and materials shall conform to all District ordinances and the District's construction standards. District must accept and approve all work and materials before backfilling and final connection is made to the sewer mains. Any violation of this provision will cause all lines and appurtenances in violation to be removed and replaced at the Applicant's expense.

2. The District shall have the right to enter upon the Applicant's premises at all reasonable times to inspect, repair, or replace any equipment used in connection with the District's service or which has an impact on said service.

3. The Applicant shall be responsible for all monthly user rates, capacity charges, and tap fees. The failure to pay any rate charge or fee may result in a lien against the property and/or the termination of service to the property, the cost of which will be borne by Applicant, including, but not limited to, all attorney's fees and collection costs.

4. The District shall not be responsible for any damages as a result of any failure to supply service unless said damages are due to default, neglect or culpability on the part of the District.

5. If there is an available sanitary sewer within three hundred (300) feet of the property line, the property owner shall be required to connect to the District's sanitary sewer system.

6. The Applicant and District agree that the provision of sanitary sewer service touches and concerns the property and the terms of this Agreement bind the District and Applicant and their heirs, executors, administrators, personal representatives, successors, agents, attorneys, assigns, designees, and transferees.

The parties hereto have read and fully understand the above provisions and agree to comply with said provisions.

FALL CREEK REGIONAL WASTE DISTRICT

Signature

STATE OF INDIANA)

) SS:

COUNTY OF MADISON)

APPLICANT

Signature

My Commission Expires:

26 July, 2006

Signature

Printed

SERRY D. KELLY
Notary Public
Resident of Madison County

INSPECTOR B DATE INSPECTED 4-10-01 APPROVED ✓ REJECTED _____

REASON FOR REJECTION _____

DATE REINSPECTED _____ APPROVED _____ REJECTED _____

NOTES:

SIZE PIPE 26" TYPE PIPE 26

BASEMENT YES _____ NO X

SUMP PUMP YES _____ NO X

DOWNSPOUT TO GROUND YES X NO _____


SEPTIC TANK PUMPED & FILLED YES X NO _____

CONTRACTOR Tim McCurdy

SPECIAL CONDITIONS _____

EXISTING HOME X

NEW CONSTRUCTION _____

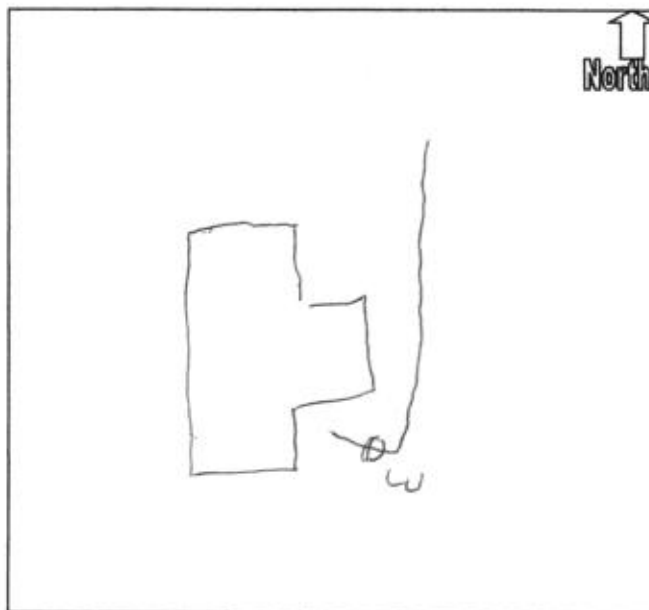

MELANIE M. SWINFORD
2883 HILLTOP CT., PH. 778-2017
ANDERSON, IN 46013

5957

Date 4-6-01

71-7258/2749
00

Pay to the
Order of

FCRWD

\$ 1872.25

One thousand eight hundred seventy two ²⁵/₁₀₀

Dollars

Security features
are included.
Details on b.



FEDERAL CREDIT UNION

2115 WEST 25TH STREET - ANDERSON, INDIANA 46016

For

Melanie M Swinford

⑆ 274972582⑆

0004130027⑈

5957

©Barke American

GUARDIAN® SAFETY YELLOW V