



## FALL CREEK REGIONAL WASTE DISTRICT

9378 S. 650 West PO Box 59  
Pendleton, IN 46064-0059 778-7544

## APPLICATION FOR SEWER PERMIT

Nº 2541

Date 8/5/98

Permit Void 90 days from Date of Issuance

Owner Name VERONICA S. BROWNProperty Address 2887 W. HUNTSVILLE RD.

Lot # \_\_\_\_\_ P.O. Box \_\_\_\_\_

Town PENDLETON, IN Zip Code 46064Phone 778-2613 City Water \_\_\_\_\_ Well X\$ N/A Tap on Fee Paid\$ N/A Inspection fee paid

Application is hereby made for connection to the Fall Creek Regional Waste District Sewer System for the above listed property - Permit Type: Residential X, Commercial \_\_\_\_\_, Industrial \_\_\_\_\_, or Governmental/Institutional \_\_\_\_\_. User Information \_\_\_\_\_.

All workmanship and materials shall conform to the standards of the District Ordinance as described in Ordinance 84-2 and 84-3 as amended. Acceptance and approval must be made by the District inspector or his duly authorized representative before backfilling and final connection is made to the main sewer lines. Any violation of applicable regulations will cause all lines and appurtenances in violation to be removed and replaced at the owners expense.

The Fall Creek Regional Waste District is responsible for the inspection, approval of materials, and installation techniques only. All costs for materials and installation and any liabilities resulting from same is the sole responsibility of the property owner.

I have read and fully understand the above provisions and agree to comply by said provisions.

Veronica S. Brown

APPLICANT(S) SIGNATURE

INSPECTOR TimDate inspected 10-1-98 Approved ✓ Rejected \_\_\_\_\_

Reason for rejection \_\_\_\_\_

Date reinspected \_\_\_\_\_ Approved \_\_\_\_\_ Rejected \_\_\_\_\_


## Notes:

Size Pipe 6"Type Pipe SDR26 Class 160Basement Yes ✓ No \_\_\_\_\_Sump Pump Yes \_\_\_\_\_ No ✓Downspout to Ground Yes ✓ No \_\_\_\_\_Septic Tank Pumped & filled Yes ✓ No \_\_\_\_\_Contractor Jerry/FREDRICKS

Special Conditions \_\_\_\_\_

Existing Home ✓

New Construction \_\_\_\_\_

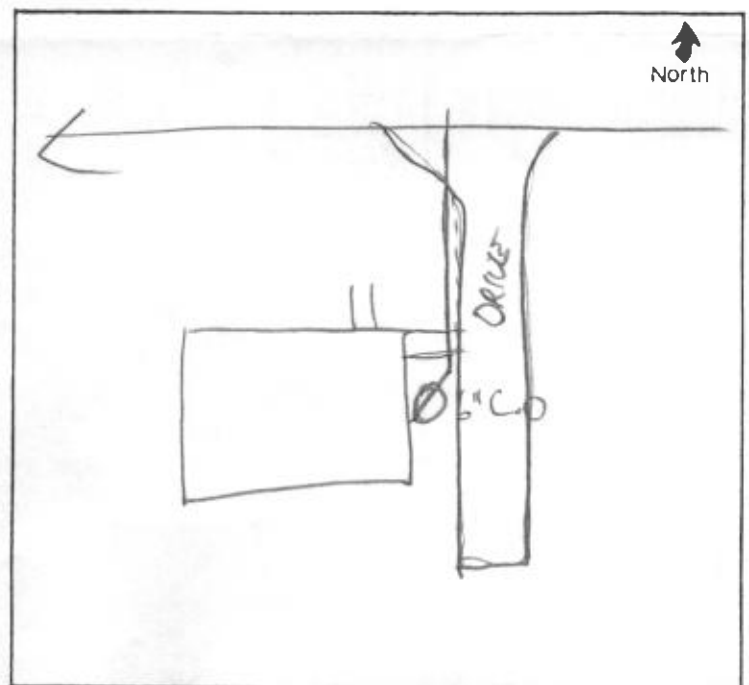

23-002-00

FALL CREEK REGIONAL WASTE DISTRICT

3215 E. 45th Street, P.O. Box 22  
P.O. Box 22, 55004-0022, 778-7244



IN 2541

APPLICATION FOR SEWER PERMIT

8/2/98

Date

Letter Void 90 days from date of issuance

Owner Name Veronica Z. Brown

Property Address 2827 W. Huntsville Rd.

Lot # 1

Town Pennington

Phone 778-2413

City Water Well

Inspection fee paid N/A

Tap on fee paid N/A

Application is hereby made for connection to the Fall Creek Regional Waste District Sewer System for the above listed property - Permit Type: Residential ☒ Commercial ☐ Industrial ☐ Other Information ☐

All workmanship and materials shall conform to the standards of the District Ordinance as herein listed in Ordinance 34-2 and 34-3 as amended. Acceptance and approval must be made by the District Inspector or his duly authorized representative before installation and final acceptance of work. The District Inspector or his duly authorized representative will conduct all work and expenditures in violation to be noted and reported at the owner's expense.

The Fall Creek Regional Waste District is responsible for the inspection, approval of materials, and installation of sewer lines. All costs for materials and installation and any additional required from same is the sole responsibility of the property owner.


I have read and fully understand the above provisions and agree to comply with said provisions.

Veronica Z. Brown  
APPLICANT'S SIGNATURE

Inspector 187

Date Inspected 8/2/98 Approved ☒ Rejected ☐

Date Inspected 8/2/98 Approved ☒ Rejected ☐

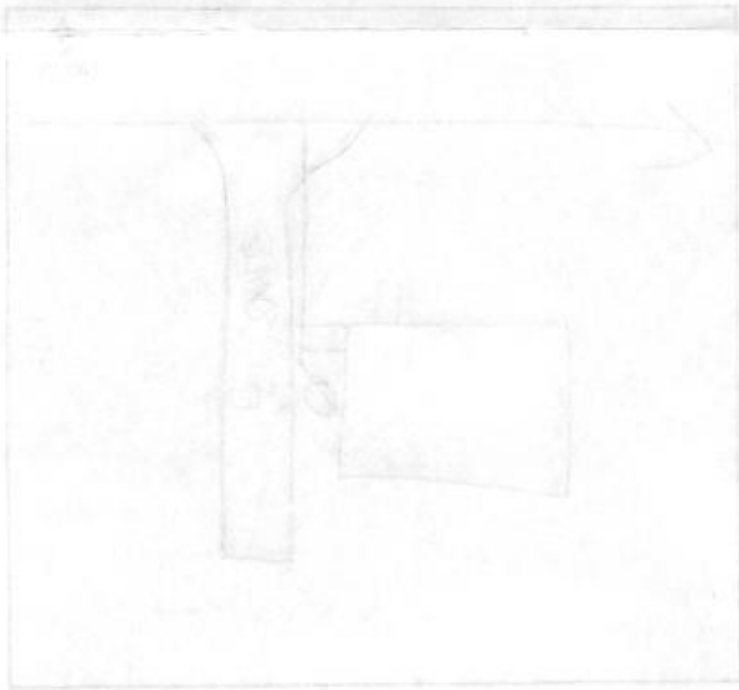

For File 2008-02-10  
Sewer Line 10'  
Sewer Pipe 10"  
Development to Street 10'  
Sewer Tank 10'  
Sewer Line 10'  
Sewer Line 10'  
