#8535

Fall Creek Regional Waste District 9378 S 650 W, P.O. Box 59, Pendleton, IN 46064 765-778-7544 Agreement for Sanitary Sewer Service

This Agreement made and entered into this 13 day of September, 20 22, between Fall Creek Regional Waste District ("District") and <u>Arbor Homes</u> ("Applicant") regarding the provision of sanitary sewer service, and the assignment of capacity in and connection to, the District's facilities for the premises located at <u>Cold Springs @ Huntzinger Farms Lot 148</u>

Frook Nining Street Address:

Now therefore, the parties, in consideration of the mutual promises set out in this Agreement, the receipt and sufficiency of which is hereby acknowledged, agree as follows:


- 1. The Applicant agrees that all workmanship and materials shall conform to all District ordinances and the District's construction standards. District must accept and approve all work and materials before backfilling and final connection is made to the sewer mains. Any violation of this provision will cause all lines and appurtenances in violation to be removed and replaced at the Applicant's expense.
- 2. The District shall have the right to enter upon the Applicant's premises at all reasonable times to inspect, repair, or replace any equipment used in connection with the District's service or which has an impact on said service.
- 3. The Applicant shall be responsible for all monthly user rates, capacity charges, and tap fees. The failure to pay any rate charge or fee may result in a lien against the property and/or the termination of service to the property, the cost of which will be borne by Applicant, including, but not limited to, all attorney's fees and collection costs.
- 4. The District shall not be responsible for any damages as a result of any failure to supply service unless said damages are due to default, neglect or culpability on the part of the District.
- 5. If there is an available sanitary sewer within three hundred (300) feet of the property line, the property owner shall be required to connect to the District's sanitary sewer system.
- 6. The Applicant and District agree that the provision of sanitary sewer service touches and concerns the property and the terms of this Agreement bind the District and Applicant and their heirs, executors, administrators, personal representatives, successors, agents, attorneys, assigns, designees, and transferees.

The parties hereto have read and fully understand the above provisions and agree to comply with said provisions.

FALL/CREEK REGIONAL WASTE DISTRICT		APPLICANT
Signature		Signature
STATE OF INDIANA)) SS:		
COUNTY OF MADISON)		
SUBSCRIBED and sworn to before me this _	day of	, 20
My Commission Expires:	Signature	
	Printed	(
		tary Public sident of County
**********	*****	sident of County
Inspector Date Inspected 5/1/25 Reason for Rejecton		
Reason for Rejecton Date Reinspected	Approved	Rejected
Notes:		
Size Pipe Type Pipe		
Basement Yes No		North
Downspout to Ground Yes No		
Septic Tank Pumped & Filled Yes No		1
Contractor DR Watson		Drawing
Special Conditions		0000
Existing Home		Drawing t
Existing Home New ConstructionX		
		1 Picture
		attached

288 Winding Brook Way

Cold Springs @ Huntzinger Lot 148 John Strange 5/1/2025

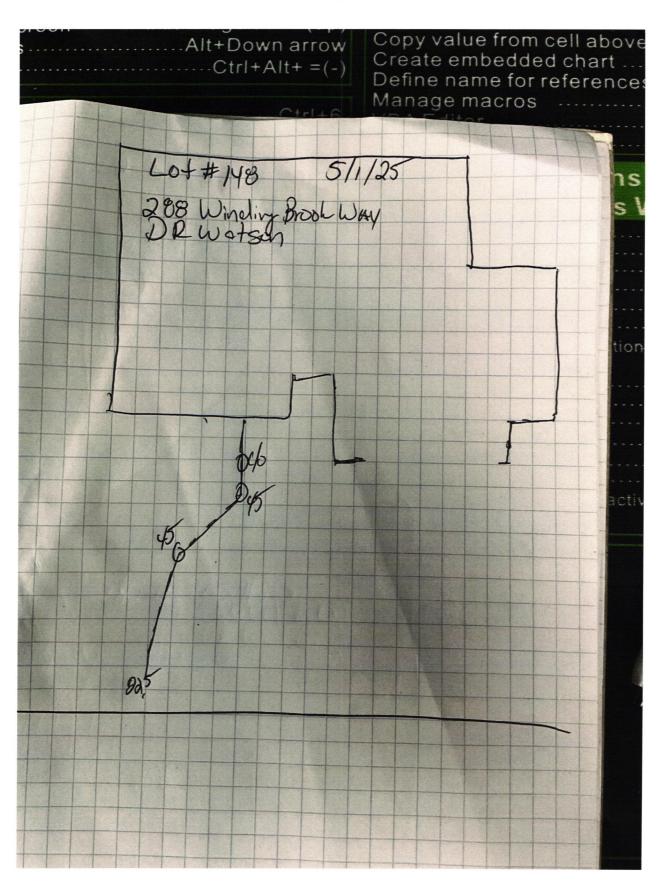

288 Winding Brook Way Cold Springs @ Huntzinger Lot 148 John Strange 5/1/2025

