



FALL CREEK REGIONAL WASTE DISTRICT

 9378 S. 650 West PO Box 59
 Pendleton, IN 46064-0059 778-7544

APPLICATION FOR SEWER PERMIT

No 2587

Date

8-12-98

Permit Void 90 days from Date of Issuance

Owner Name

Marie Ridge

Property Address

2912 Huntsville Road

Lot #

P.O. Box

Town

Pendleton

IN Zip Code

Phone

City Water

Well

☒

\$

N/A

Tap on Fee Paid

\$

N/A

Inspection fee paid

Application is hereby made for connection to the Fall Creek Regional Waste District Sewer System for the above listed property - Permit Type: Residential ☒, Commercial ☐, Industrial ☐, or Governmental/Institutional ☐. User Information

All workmanship and materials shall conform to the standards of the District Ordinance as described in Ordinance 84-2 and 84-3 as amended. Acceptance and approval must be made by the District inspector or his duly authorized representative before backfilling and final connection is made to the main sewer lines. Any violation of applicable regulations will cause all lines and appurtenances in violation to be removed and replaced at the owners expense.

The Fall Creek Regional Waste District is responsible for the inspection, approval of materials, and installation techniques only. All costs for materials and installation and any liabilities resulting from same is the sole responsibility of the property owner.

I have read and fully understand the above provisions and agree to comply by said provisions.

Marie Ridge

APPLICANT(S) SIGNATURE

INSPECTOR

Tim

Date inspected

9-11-98

Approved

☒

Rejected

Reason for rejection

Date reinspected

Approved

Rejected

Notes:

Size Pipe

6"

Type Pipe

SDR26 Class 160

Basement Yes

☒ No

Sump Pump Yes

☒ No

Downspout to Ground Yes

☒ No

Septic Tank Pumped & filled Yes

☒ No

Contractor


Max Mercer

Special Conditions

Existing Home

☒

New Construction

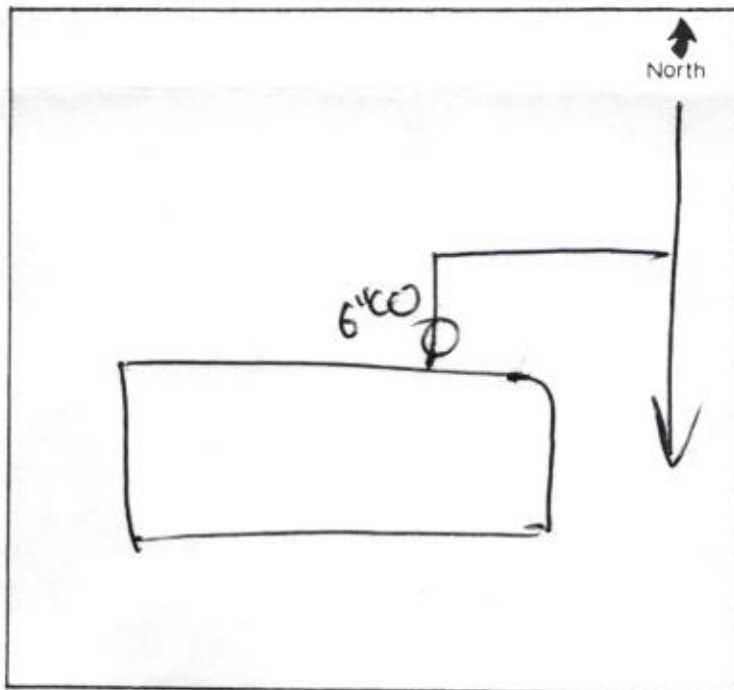

FALL CREEK REGIONAL WATER DISTRICT



7825

8/1/80

Water Treatment Plant

Installation

N/A

N/A

4-11-80

Water Meter

