



## FALL CREEK REGIONAL WASTE DISTRICT

9378 S. 650 West PO Box 59  
Pendleton, IN 46064-0059 778-7544

## APPLICATION FOR SEWER PERMIT

Nº 2539

Date 29 JUL 98

Permit Void 90 days from Date of Issuance

Owner Name RONALD DEBORAH KNOTTS McCORDProperty Address 2918 W. HOUTSVILLE RD

Lot # \_\_\_\_\_ P.O. Box \_\_\_\_\_

Town Pendleton, IN Zip Code 46064Phone 778 4732 City Water \_\_\_\_\_ Well X\$ NA Tap on Fee Paid\$ NA Inspection fee paid

Application is hereby made for connection to the Fall Creek Regional Waste District Sewer System for the above listed property - Permit Type: Residential X, Commercial \_\_\_\_\_, Industrial \_\_\_\_\_, or Governmental/Institutional \_\_\_\_\_. User Information \_\_\_\_\_.

All workmanship and materials shall conform to the standards of the District Ordinance as described in Ordinance 84-2 and 84-3 as amended. Acceptance and approval must be made by the District inspector or his duly authorized representative before backfilling and final connection is made to the main sewer lines. Any violation of applicable regulations will cause all lines and appurtenances in violation to be removed and replaced at the owners expense.

The Fall Creek Regional Waste District is responsible for the inspection, approval of materials, and installation techniques only. All costs for materials and installation and any liabilities resulting from same is the sole responsibility of the property owner.

I have read and fully understand the above provisions and agree to comply by said provisions.

X Ronald McCord

APPLICANT(S) SIGNATURE

INSPECTOR BDate inspected 9-16-98 Approved ✓ Rejected \_\_\_\_\_

Reason for rejection \_\_\_\_\_

Date reinspected \_\_\_\_\_ Approved \_\_\_\_\_ Rejected \_\_\_\_\_

## Notes:


Size Pipe 6"Type Pipe 26 160Basement Yes \_\_\_\_\_ No ✓Sump Pump Yes \_\_\_\_\_ No ✓Downspout to Ground Yes ✓ No \_\_\_\_\_Septic Tank Pumped & filled Yes ✓ No \_\_\_\_\_Contractor M & M

Special Conditions \_\_\_\_\_

Existing Home ✓

New Construction \_\_\_\_\_

↑  
North

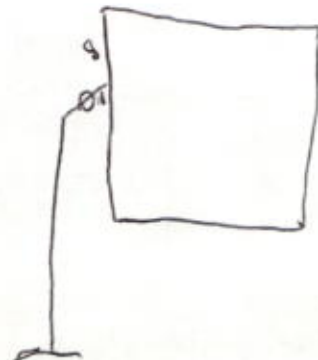

FALL CREEK REGIONAL WASTE DISTRICT  
 2337 N. 650 WEST - PO BOX 29  
 BENTON, IN 46804-0029 318-7544



IN 2239

APPLICATION FOR STATE TRACT

DATE 2/21/77

OWNER NAME Ronald Debrah L. M. Carr  
 TRACT NO. 2239  
 TRACT AREA 1.00 AC.  
 TRACT LOCATION Section 1, T12N, R12E, S12E  
 TRACT MAP REF. NA  
 TRACT MAP DATE NA


Application is hereby made for connection to the Fall Creek Regional Waste District sewer system for the above listed property - (sewer type) Sanitary Industrial Other None  
 All applications for connection to the sewer system must be accompanied by a plat showing the location of the proposed connection and the location of the property to be connected. The plat must also show the location of the property to be connected to the sewer system and the location of the property to be connected to the sewer system. The plat must also show the location of the property to be connected to the sewer system and the location of the property to be connected to the sewer system.

Approval is requested for the proposed connection and the location of the property to be connected. The plat must also show the location of the property to be connected to the sewer system and the location of the property to be connected to the sewer system.

I, the undersigned, hereby certify that the above information is true and correct to the best of my knowledge and belief.

X Donald Debrah L. M. Carr  
 Signature

DATE SUBMITTED 2/21/77  
 DATE RECEIVED 2/21/77  
 BY NA  
 FOR NA

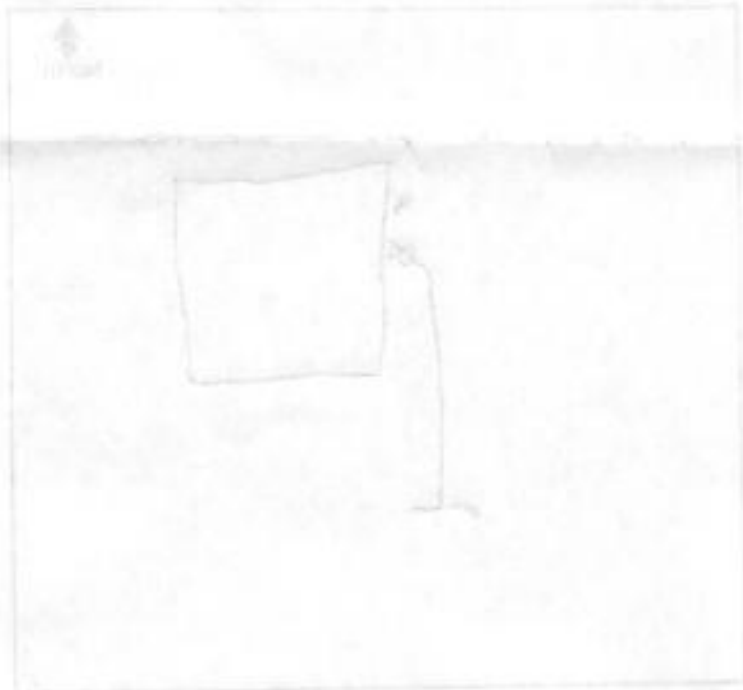

PLAT NO. 2239  
 PLAT DATE 2/21/77  
 PLAT AREA 1.00 AC.  
 PLAT LOCATION Section 1, T12N, R12E, S12E  
 PLAT MAP REF. NA  
 PLAT MAP DATE NA