

FALL CREEK REGIONAL WASTE DISTRICT

9378 S 650 WEST, P.O. BOX 59, PENDLETON, IN 46064

765-778-7544

AGREEMENT FOR SANITARY SEWER SERVICE

This Agreement made and entered into this 25th day of April, 2001, between FALL CREEK REGIONAL WASTE DISTRICT ("District") and Randall Farmer ("Applicant") regarding the provision of sanitary sewer service, and the assignment of capacity in, and connection to, the District's facilities for the premises located at 2961 W. Ridge Lane.

NOW THEREFORE, the parties, in consideration of the mutual covenants and conditions set forth herein, and the receipt and sufficiency of which is hereby acknowledged, agree as follows:

1. The Applicant agrees that all workman shall conform to all District ordinances and standards. District must inspect all materials before backfilling and final connection is made to the sewer mains. Any violation of standards and appurtenances in violation to be removed and replaced at the Applicant's expense.

2. The District shall have the right to enter the property at all reasonable times to inspect, repair, or replace any equipment used in connection with the sewer service or which has an impact on said service.

3. The Applicant shall be responsible for all monthly user rates, capacity charges, and tap fees. The failure to pay any rate charge or fee may result in a lien against the property and/or the termination of service to the property, the cost of which will be borne by Applicant, including, but not limited to, all attorney's fees and collection costs.

4. The District shall not be responsible for any damages as a result of any failure to supply service unless said damages are due to default, neglect or culpability on the part of the District.

5. If there is an available sanitary sewer within three hundred (300) feet of the property line, the property owner shall be required to connect to the District's sanitary sewer system.

6. The Applicant and District agree that the provision of sanitary sewer service touches and concerns the property and the terms of this Agreement bind the District and Applicant and their heirs, executors, administrators, personal representatives, successors, agents, attorneys, assigns, designees, and transferees.

The parties hereto have read and fully understand the above provisions and agree to comply with said provisions.

FALL CREEK REGIONAL WASTE DISTRICT
Deborah L. Wilson
Signature

APPLICANT
Randy Farmer
Signature

STATE OF INDIANA)
) SS:
COUNTY OF MADISON)

SUBSCRIBED and sworn to before me this 25th day of April, 2001.

My Commission Expires:
2-20-2008

Signature Deborah L. Wilson

Printed Deborah L. Wilson

Notary Public
Resident of Madison County

INSPECTOR Tim DATE INSPECTED 8-17-01 APPROVED ✓ REJECTED _____

REASON FOR REJECTION _____

DATE REINSPECTED _____ APPROVED _____ REJECTED _____

NOTES:
SIZE PIPE 6" TYPE PIPE SDR35

BASEMENT YES ✓ NO _____

SUMP PUMP YES _____ NO ✓

DOWNSPOUT TO GROUND YES ✓ NO _____


SEPTIC TANK PUMPED & FILLED YES ✓ NO _____

CONTRACTOR TEOS

SPECIAL CONDITIONS _____

EXISTING HOME ✓

NEW CONSTRUCTION _____

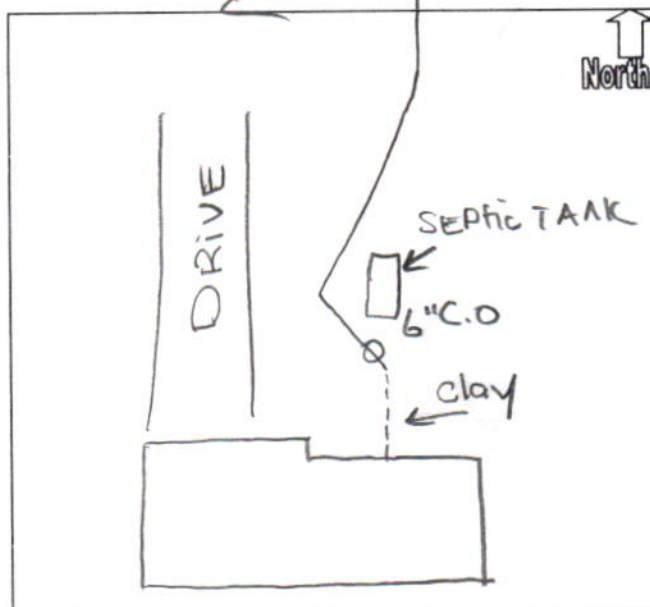

ELIZABETH A. FARMER 01-94
RANDY J. FARMER
2961 RIDGE LN. PH. 317-778-3382
ANDERSON, IN 46013

20-7043/2740
170000707

3089

DATE 4-25-01

PAY TO THE
ORDER OF

FCRWD

\$ 1326.95

THIRTEEN HUNDRED TWENTY SIX DOLLARS

95/100

DOLLARS  Security features
included.
Details on back.



FIRST INDIANA[®] BANK
INDIANAPOLIS, INDIANA 46204

MEMO

Hook Up FEE

Randy J. Farmer MP

⑆ 274070439⑆

3089

SAFETY PAPER