



CONSTRUCTION SERVICES

- RESIDENTIAL
- COMMERCIAL
- MUNICIPAL
- INDUSTRIAL

GENERAL CONSTRUCTION

SITE CONSTRUCTION
AND GRADING
WATER MAINS & SERVICES
BOOSTER PUMP STATIONS
SANITARY MAINS & SERVICES
LIFT STATIONS & GRINDERS
STORM SEWER
CONCRETE WORK
STEEL BUILDINGS
HYDRO-EXCAVATING

PIPELINE SERVICES

VALVE INSERTION
LINE STOPPING
PRESSURE/HOT TAPS
LEAK DETECTION
PRESSURE TESTING
CHLORINATION AND
DECHLORINATION
COMMERCIAL DIVING

SPECIAL SERVICES

MANHOLE RELINING
CEMENTITIOUS/EPOXY
INJECTION GROUTING
CHIMNEY SEALS
MANHOLE CASTING REPAIR
AND REPLACEMENT
PIPELINE ACCESSMENT
PIPE PATCH
HYDRO-VAC
SEWER CLEANING
SEWER TELEVISION
PUMP & EQUIPMENT REPAIRS

24 HOUR EMERGENCY
CONTACT AND SERVICE
OSHA SAFETY TRAINED

PH: (765) 584-8509

FAX: (765) 584-8060

5 INDUSTRIAL PARK DRIVE
P.O. BOX 29
WINCHESTER, IN 47394

www.culycontracting.com

299 Falls Park - Museum

PROJECT: ~~300~~


DATE: _____

~~300~~ ~~to 300~~

5-14-19


Atlas Excavating

Foreman Brad Whitaker

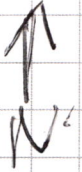

4" Kitchen Drain

5-14-19

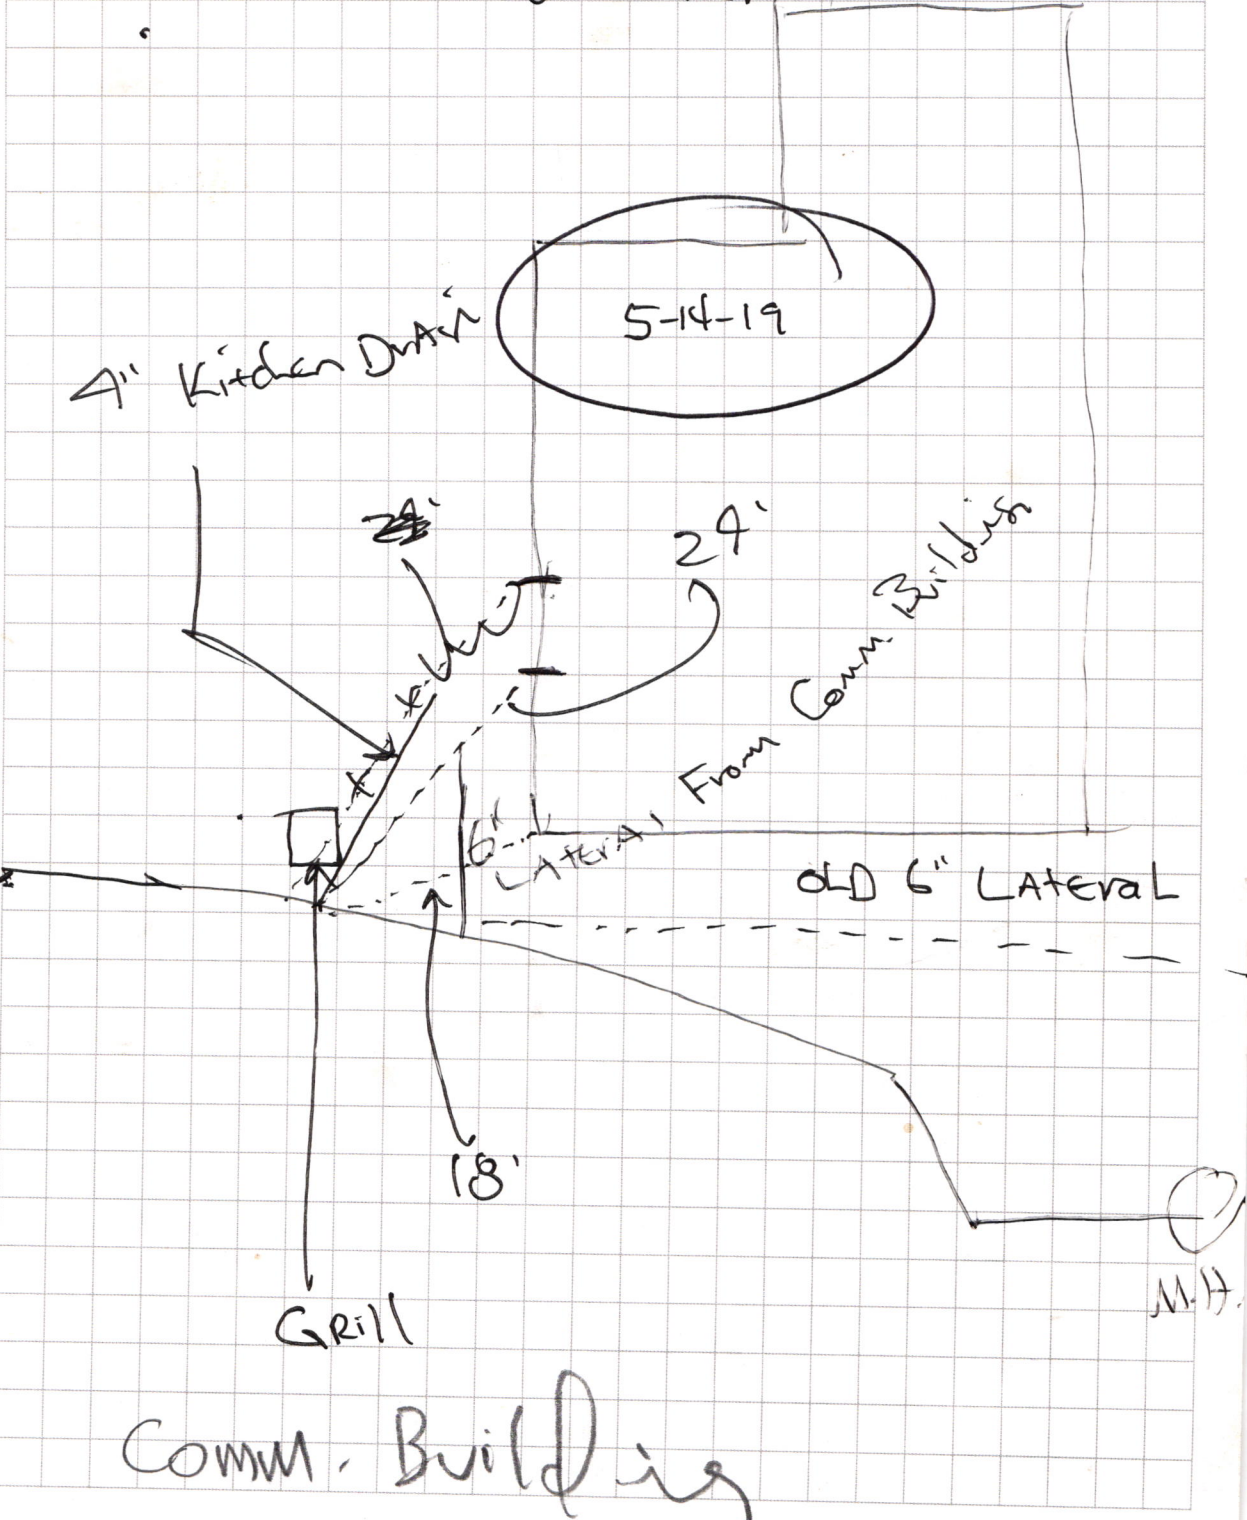

Grill

Comm. Building

M.H.

299 Falls Park Dr Museum



299 Falls Park Dr

Museum





Community Building

299 Falls Park DR

5-13583.00

Tim McCurdy OCT 2021



Community Building

299 Falls Park DR

5-13583.00

Tim McCurdy OCT 2021



Community Blog

299 Falls Park

T McCurdy

Oct 2021







299 Falls Park DR

Community Building

Per Tim McCurdy 12/12/2022

Stake through sewer lateral