



# FALL CREEK REGIONAL WASTE DISTRICT

9378 S. 650 West PO Box 59  
Pendleton, IN 46064-0059 778-7544

## APPLICATION FOR SEWER PERMIT

Nº 2598

Date 8/27/98

Permit Void 90 days from Date of Issuance

Owner Name Timothy Shirley

Property Address 3007 N. Monticello Rd

Lot # 2 P.O. Box \_\_\_\_\_

Town PENDLETON, IN Zip Code 46064

Phone 765-778-8127 City Water \_\_\_\_\_ Well \_\_\_\_\_

\$ N/A Tap on Fee Paid

\$ N/A Inspection fee paid

Application is hereby made for connection to the Fall Creek Regional Waste District Sewer System for the above listed property - Permit Type: Residential ☒, Commercial \_\_\_\_\_, Industrial \_\_\_\_\_, or Governmental/Institutional \_\_\_\_\_. User Information \_\_\_\_\_.

All workmanship and materials shall conform to the standards of the District Ordinance as described in Ordinance 84-2 and 84-3 as amended. Acceptance and approval must be made by the District inspector or his duly authorized representative before backfilling and final connection is made to the main sewer lines. Any violation of applicable regulations will cause all lines and appurtenances in violation to be removed and replaced at the owners expense.

The Fall Creek Regional Waste District is responsible for the inspection, approval of materials, and installation techniques only. All costs for materials and installation and any liabilities resulting from same is the sole responsibility of the property owner.

I have read and fully understand the above provisions and agree to comply by said provisions.

Timothy E. Shirley  
APPLICANT(S) SIGNATURE

\*\*\*\*\*

INSPECTOR JS

Date inspected 11-1-98 Approved ☒ Rejected \_\_\_\_\_

Reason for rejection \_\_\_\_\_

Date reinspected \_\_\_\_\_ Approved \_\_\_\_\_ Rejected \_\_\_\_\_

### Notes:

Size Pipe 6"

Type Pipe SDR 26 class 160

Basement Yes ☒ No \_\_\_\_\_

Sump Pump Yes ☒ No \_\_\_\_\_

Downspout to Ground Yes ☒ No \_\_\_\_\_


Septic Tank Pumped & filled Yes ☒ No \_\_\_\_\_

Contractor M&M EXCAVATING INC.

Special Conditions \_\_\_\_\_

Existing Home ☒

New Construction \_\_\_\_\_

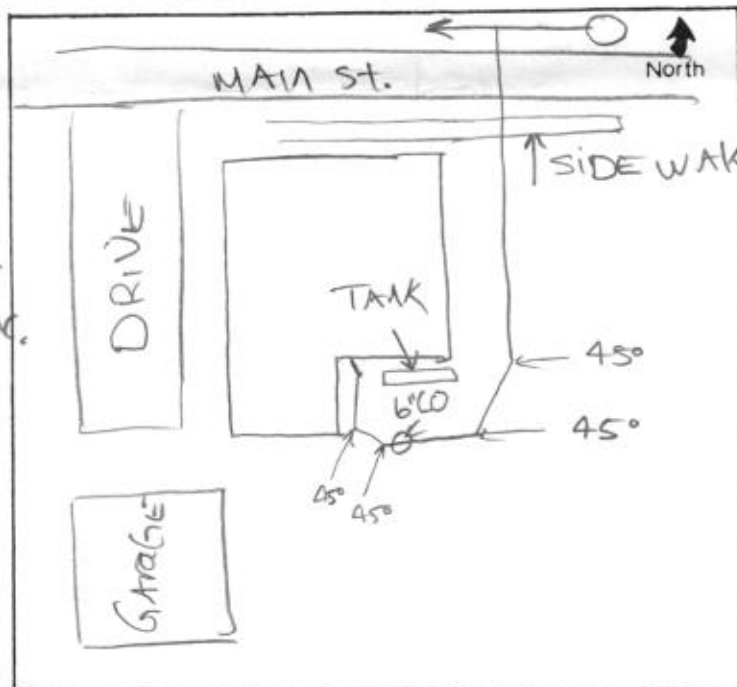

FALL CREEK REGIONAL WASTE DISTRICT

2010 N. 25th Street, PO Box 99  
Fond du Lac, WI 54601-0099  
715-921-1234



IN 2288

WILL NOTION FOR NEWER CONSENT

6/27/02

Project Name: County of Lincoln

Project Address: 2010 N. 25th Street

46004

IN 2288

715-921-1234

City Name: Well

City Name: Well

City Name: Well

Agreement is hereby made for the construction of the Fall Creek Regional Waste District for the above listed project - Project Type: Industrial ☒ Commercial ☐ Residential ☐ Other ☐

All engineering and materials shall comply with the standards of the District as set forth in the District Ordinance 10-1 and 10-2 as amended. The contractor shall be responsible for obtaining all necessary permits and for obtaining all necessary approvals from the District. The contractor shall be responsible for obtaining all necessary approvals from the District. The contractor shall be responsible for obtaining all necessary approvals from the District.

The contractor shall be responsible for obtaining all necessary approvals from the District. The contractor shall be responsible for obtaining all necessary approvals from the District. The contractor shall be responsible for obtaining all necessary approvals from the District.

The contractor shall be responsible for obtaining all necessary approvals from the District. The contractor shall be responsible for obtaining all necessary approvals from the District. The contractor shall be responsible for obtaining all necessary approvals from the District.

County of Lincoln

Project Name: County of Lincoln

Project Address: 2010 N. 25th Street

City Name: Well

City Name: Well

