

Side.

PROJECT

Phase II

SHEET

OF

SUBJECT

DATE


7-10-08

JOB NO.

4447

BY

Atlas

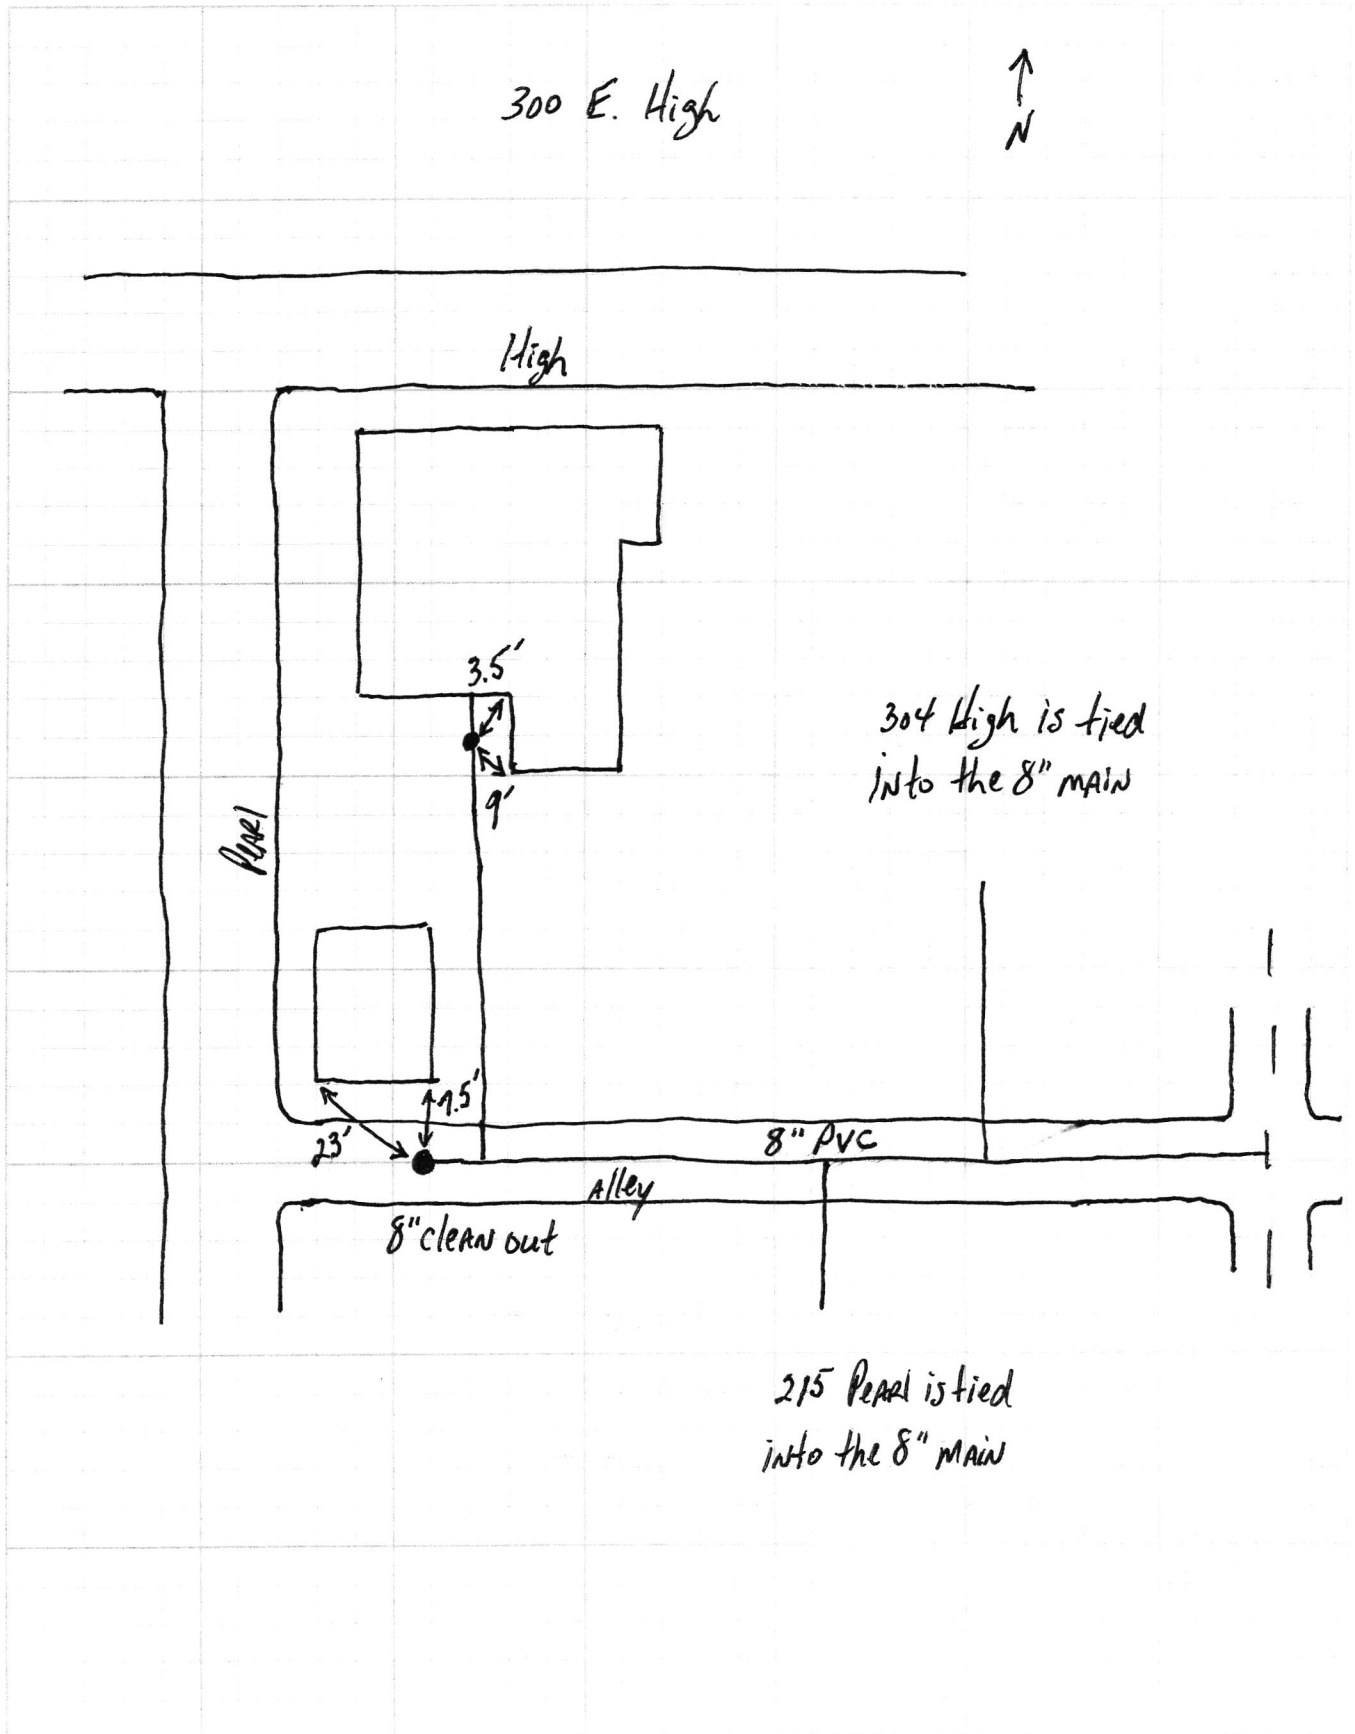



300 & High

SPE Phase II

7.11.18

